



August 1, 2003

Mr. Floyd D. Nichols
On Scene Coordinator
USEPA Region 8
999 18th St., Suite 300
Denver, CO 80202-2466

Dear Mr. Nichols,

Attached are the 'as built' drawings and layout of the Traction Power Substation (TPSS) at the Delta Center Substation, 147 South 400 West, Salt Lake City. As will see there are many points of potential impact for possible contact with high voltage electricity.


We have not been able to find any records indicating that any excavated material was removed from the site during construction. We are also interviewing some of those who may have worked on the project to see if they remember any material being removed from the site. It was standard practice during construction to leave any material on the site as much as possible. It is indicated right now that material not placed into the foundation of the TPSS was graded back into the site.

We are in the process of getting the Utah Power Property Transaction ESA Baseline Report released send to you. That should be done by next week.



Sincerely,

Grantley Martelly, REM
Utah Transit Authority
3600 South 700 West
Salt Lake City, UT 84130


L:\North-South As-built\CAD Work\As-Built Submittal April 2003\L54\L54tp661.dwg, 06/23/2003 03:45:10 PM, cslama, Carlee S

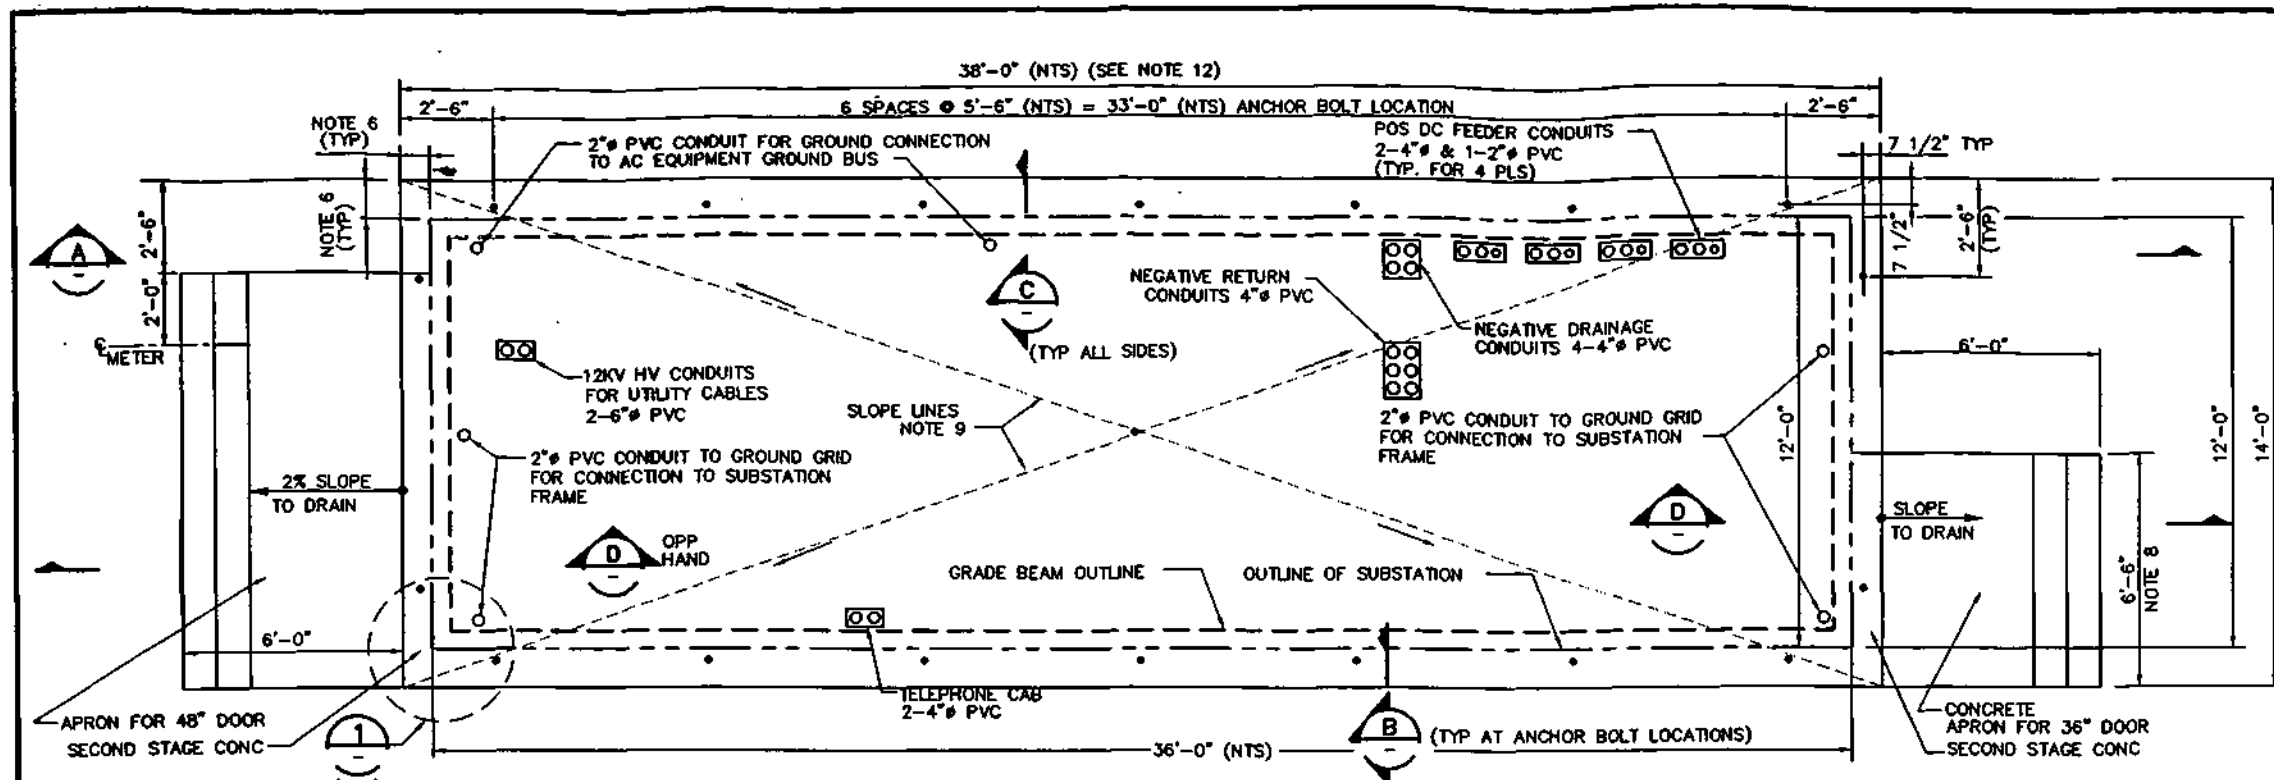


- NOTES:**
1. MINIMUM CONCRETE COMPRESSIVE STRENGTH SHALL BE (f_c) = 3000 PSI AT 28 DAYS.
 2. CONCRETE SHALL BE TROWELLED TO SMOOTH FINISH TO PREVENT STANDING WATER.
 3. CONTRACTOR SHALL REMOVE SOIL TO A DEPTH OF AT LEAST FOUR FEET BELOW PAD ELEVATION FOR INSTALLATION OF GROUND MAT. ALL BACKFILL MATERIAL SHALL BE COMPACTED TO 95% OF THE MAXIMUM DENSITY.
 4. SKID IS PART OF UTA FURNISHED SUBSTATION.
 5. CONTRACTOR SHALL CONFIRM THE LOCATION OF ALL CONDUIT STUB-UPS, ANCHOR BOLTS, FOUNDATION SLABS WITH SUBSTATION EQUIPMENT LAYOUT PLANS, PROVIDED BY THE ENGINEER.
 6. CONFIRM ALL SKID DIMENSIONS WITH ENGINEER PRIOR TO CONSTRUCTION OF CONCRETE SLAB.
 7. ALL CONDUIT STUB-UPS SHALL BE 6 INCHES ABOVE FINISH FLOOR.
 8. COORDINATE FINAL APRON DIMENSIONS WITH SUBSTATION DOOR LOCATIONS.
 9. SLOPE 1/8 INCH FROM CENTER OF SLAB TO EACH CORNER TO PREVENT STANDING WATER.
 10. SLOPE FINISH GRADE A MINIMUM OF 2% ALL AROUND SLAB.
 11. ALL EXPOSED EDGES OF CONCRETE SHALL BE CHAMFERED 1" AT 45°.
 12. DIMENSIONS SHOWN ARE FOR MAIN LINE SUBSTATION. ADJUST DIMENSIONS AS REQUIRED FOR YARD SUBSTATION.

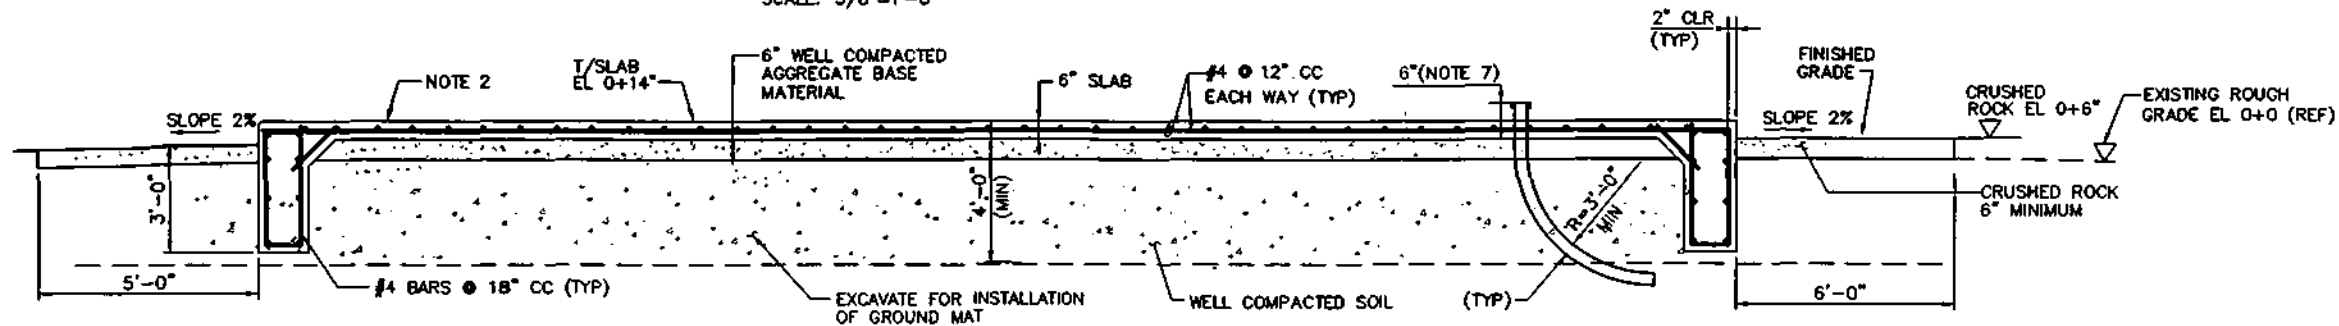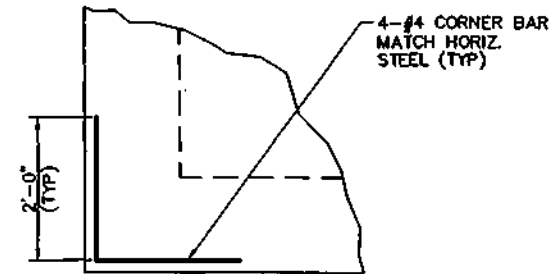


DETAIL 1
CORNER BARS
NTS

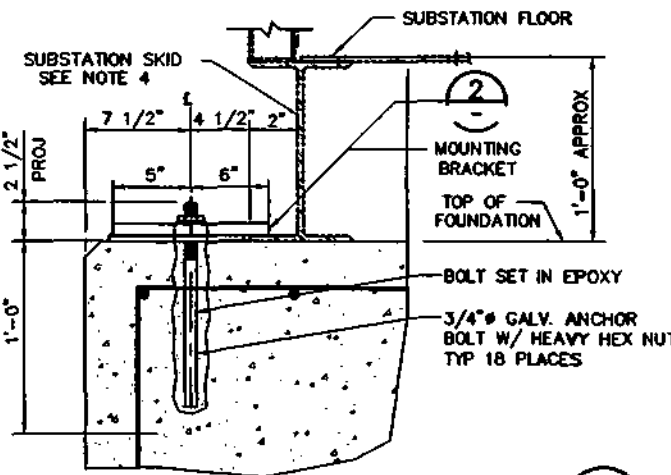


SECTION B
NTS

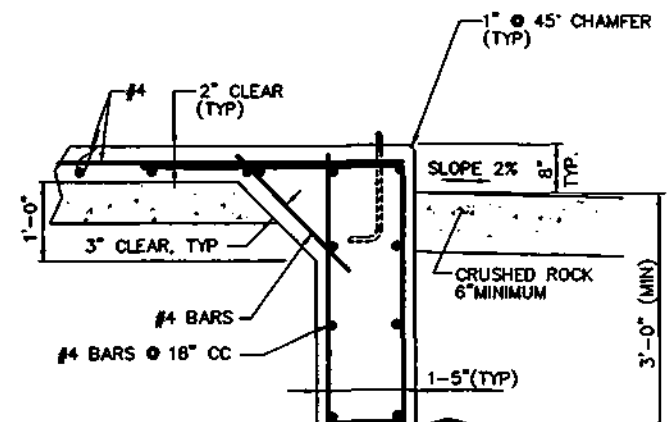

SECTION C
TYPICAL AT GRADE BEAM
NTS

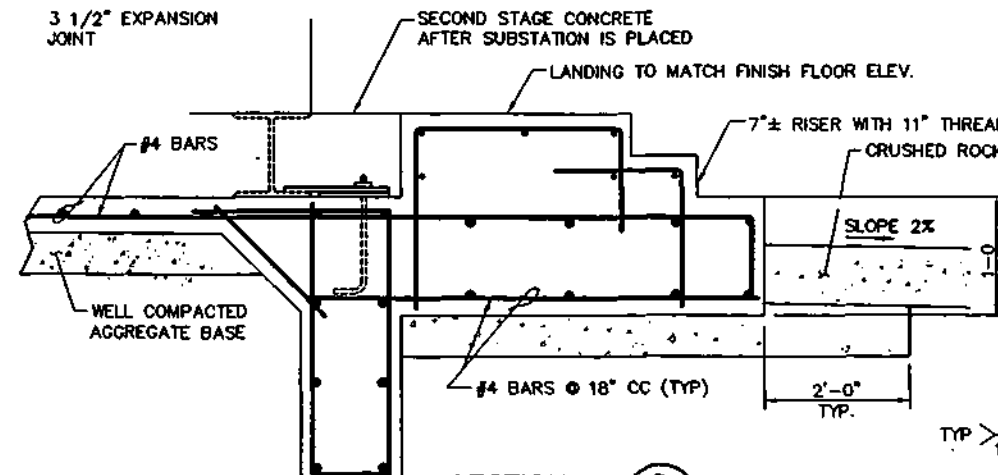


SECTION D
NTS

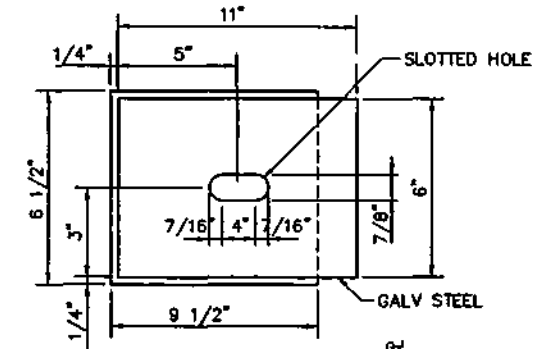

DETAIL 2
MOUNTING BRACKET
NTS


REV	DATE	DESCRIPTION
1	6/8/02	AS-BUILT MARK UP BY UTA
2	11/26/97	PC 03
3	8/23/97	ISSUED FOR CONSTRUCTION

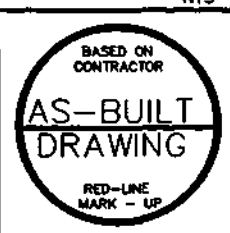

Designed By:	Z. JARKIEWCZ
Drawn By:	C.M. WONG
Checked By:	
Approved By:	


TRACTION POWER AND SIGNALING	
TRACTION POWER SUBSTATION	
TYPICAL SUBSTATION FOUNDATION	
Scale:	AS SHOWN
CADD Filename:	L54TP661
Submital Date:	MAY 13, 1997
UTA Contract No.:	UT-17VT-L54
Drawing No.:	TP661
Sheet No.:	169

- NOTES:
1. DUCTBANKS AND PULL BOXES ON THIS DRAWING ARE BY CIVIL CONTRACT.
 2. FOR CABLE SCHEDULE, SEE DWG TP741.

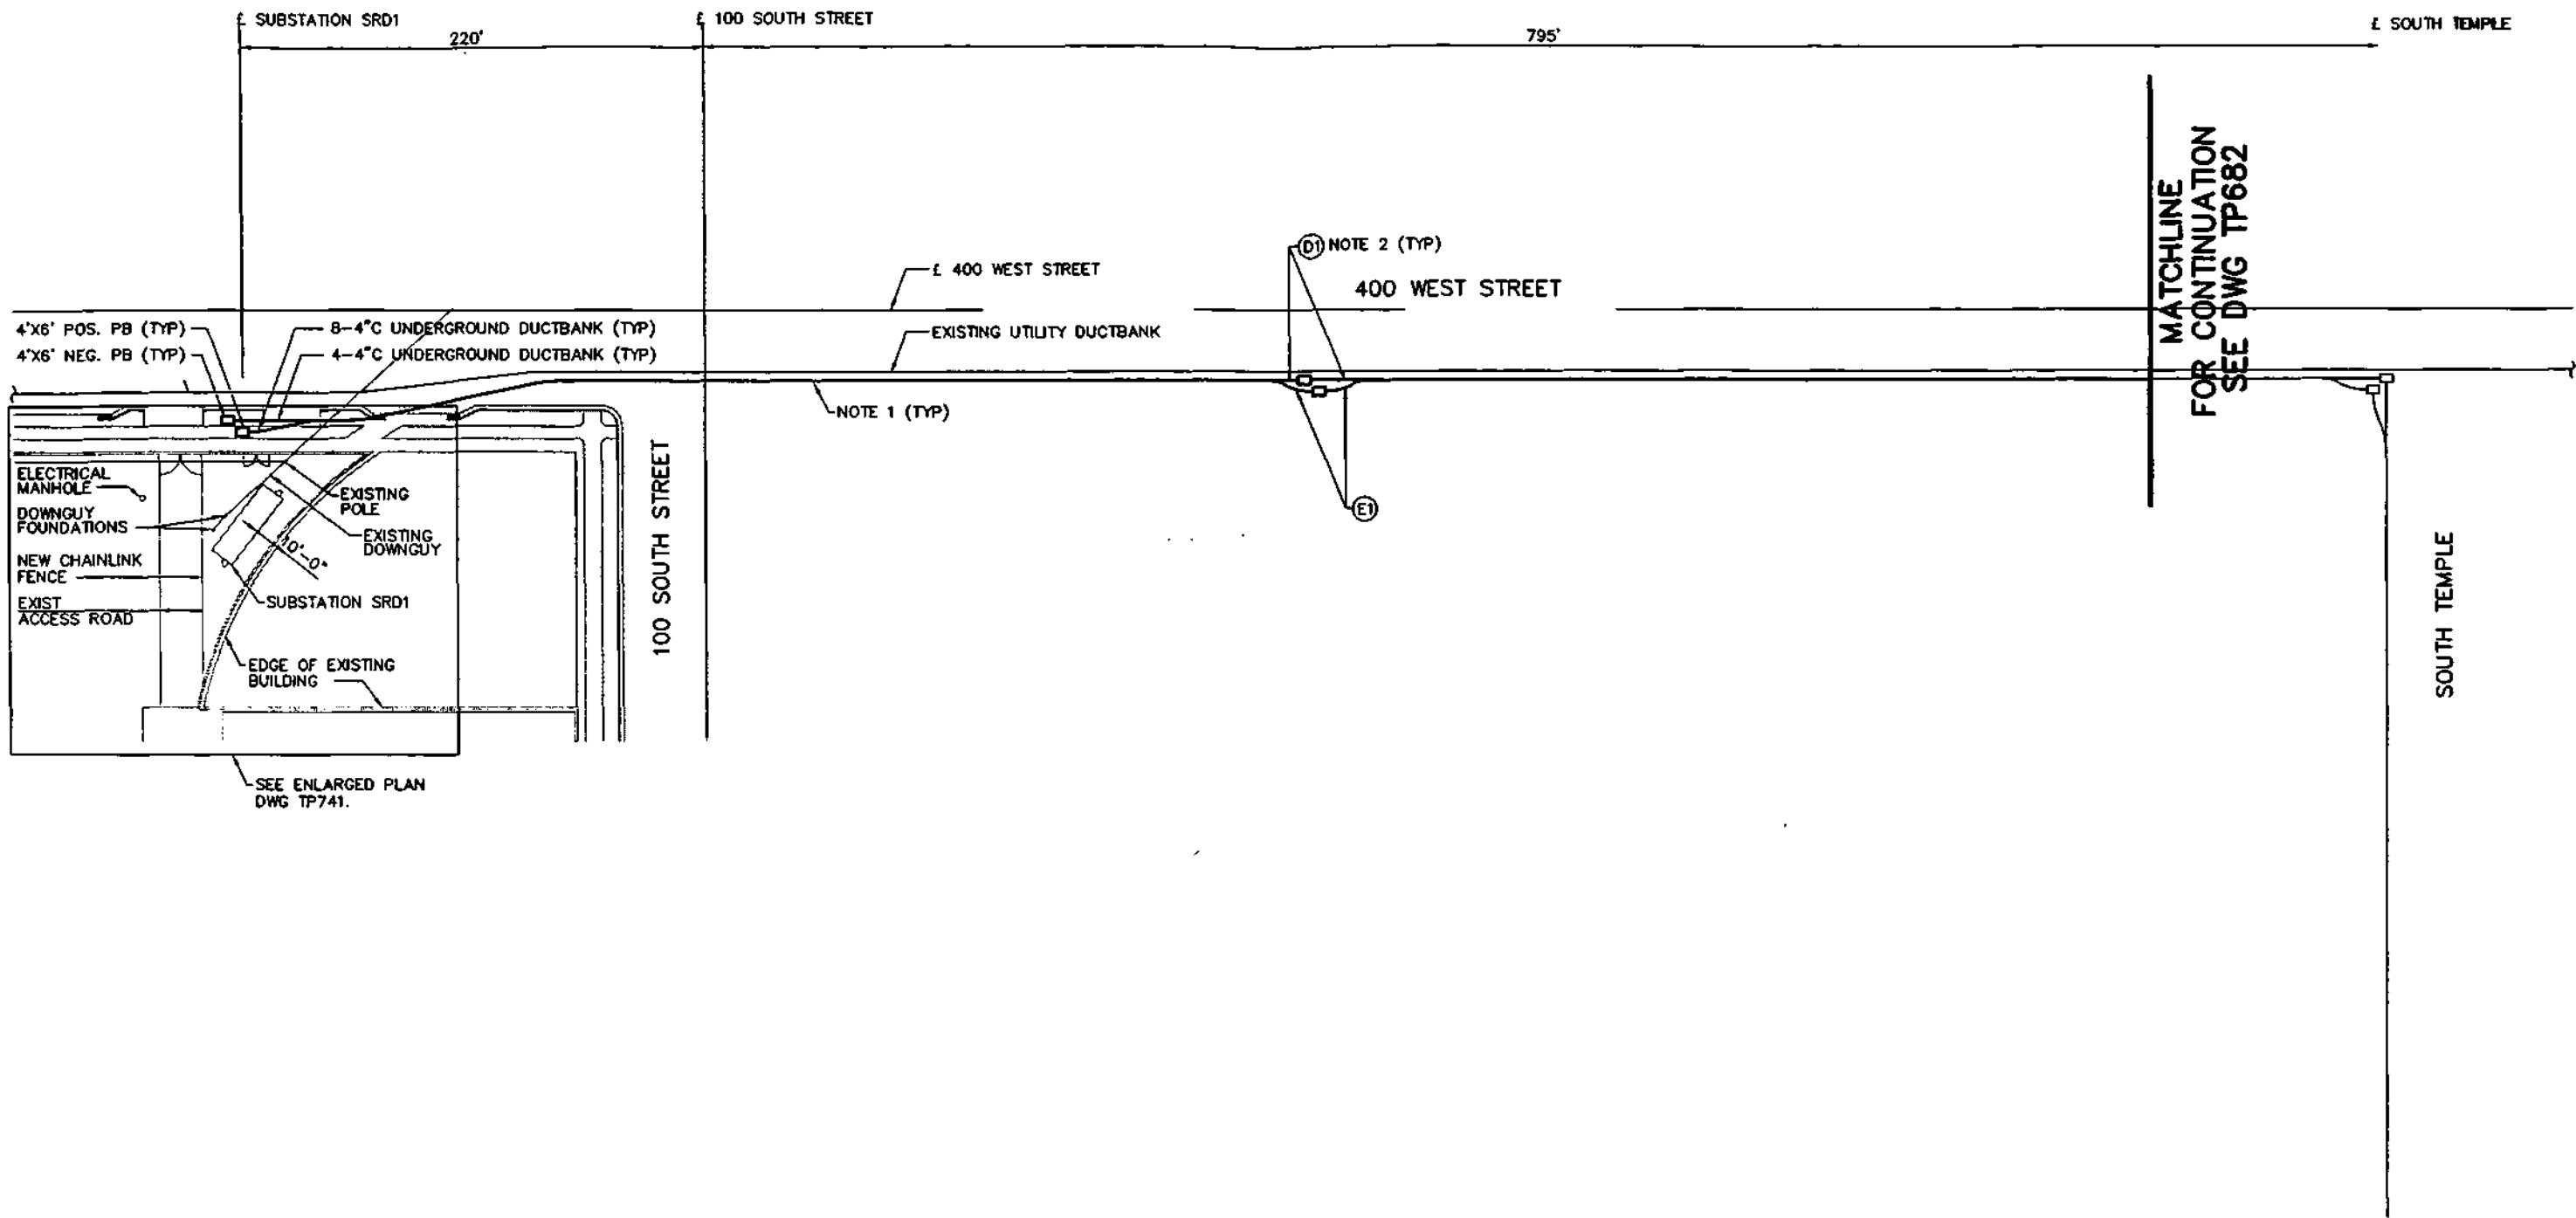

PROJECT CONTROL DATE: 08/26/97 15:50:00 CAD FILENAME: C:\UTA\154\154P670.DWG (C8) RD/DHL PLOTTED SCALE: 1"=40'-0"

REV	DATE	DESCRIPTION
1	12/18/02	AS-BUILT MARK-UPS BY UTA
2	8/23/97	ISSUED FOR CONSTRUCTION

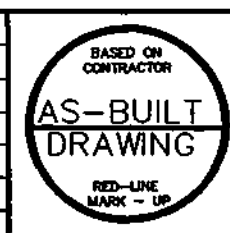

PGH Wong Engineering, Inc.
San Francisco, California

Submitted By: _____


UTA TRAX
SALT LAKE BUS/RAIL PROJECT
UTAH TRANSIT AUTHORITY

Approved By: _____


Designed By:	R.C. DHINGRA
Drawn By:	F. FONG
Checked By:	
Approved By:	

TRACTION POWER AND SIGNALING II
DELTA CENTER SUBSTATION
UNDERGROUND RACEWAY AND CABLE PLANS
SUBSTATION SRD1
SHEET 1 OF 2

Scale:	1"=40'-0"
CAD Filename:	154P740
Scale Date:	MAY 13, 1997
UTA Drawing No:	UT-17VT-L54
Drawing No:	1740
Sheet No:	199

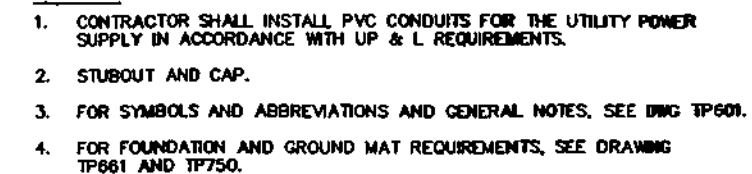

△		
△		
△	8/23/97	ISSUED FOR CONSTRUCTION
REV	DATE	Description

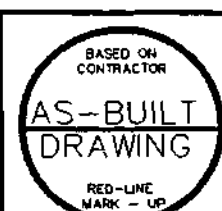

PGH Wong Engineering, Inc.
San Francisco, California

UTA  TRAX
SALT LAKE BUS/RAIL PROJECT
UTAH TRANSIT AUTHORITY

Approved By _____

Designed By:	R. DHINGRA
Drawn By:	F. FONG
Checked By:	
Approved By:	

**TRACTION POWER AND SIGNALING
DELTA CENTER SUBSTATION
UNDERGROUND RACEWAY AND CABLE PLANS
SUBSTATION SRD1
SHEET 2 OF 2**

Scale: 1"=10'-0"	
CAOB Filing L54TP748	
Submitted Date MAY 13, 1997	
UTA Contract No. 05-17/T-L54	
Drawing No: TP748	Sheet No.: 200



1
TP741



SCALE: 1" = 1'-0"




UTA  TRAX
SALT LAKE BUS/RAIL PROJECT
UTAH TRANSIT AUTHORITY

Designed By:	G. GIN
Drawn By:	S. LEE
Checked By:	
Approved By:	

**TRACTION POWER AND SIGNALING
DELTA CENTER SUBSTATION
PAD MOUNTED DISCONNECT SWITCHES
DETAILS**


Scale: AS SHOWN	
CADD Filename: L54TP742	
Submitted Date: MAY 13, 1997	
UTA Contract No.: UT-17VT-L54	
Grading No.: TP742	Sheet No.: 20

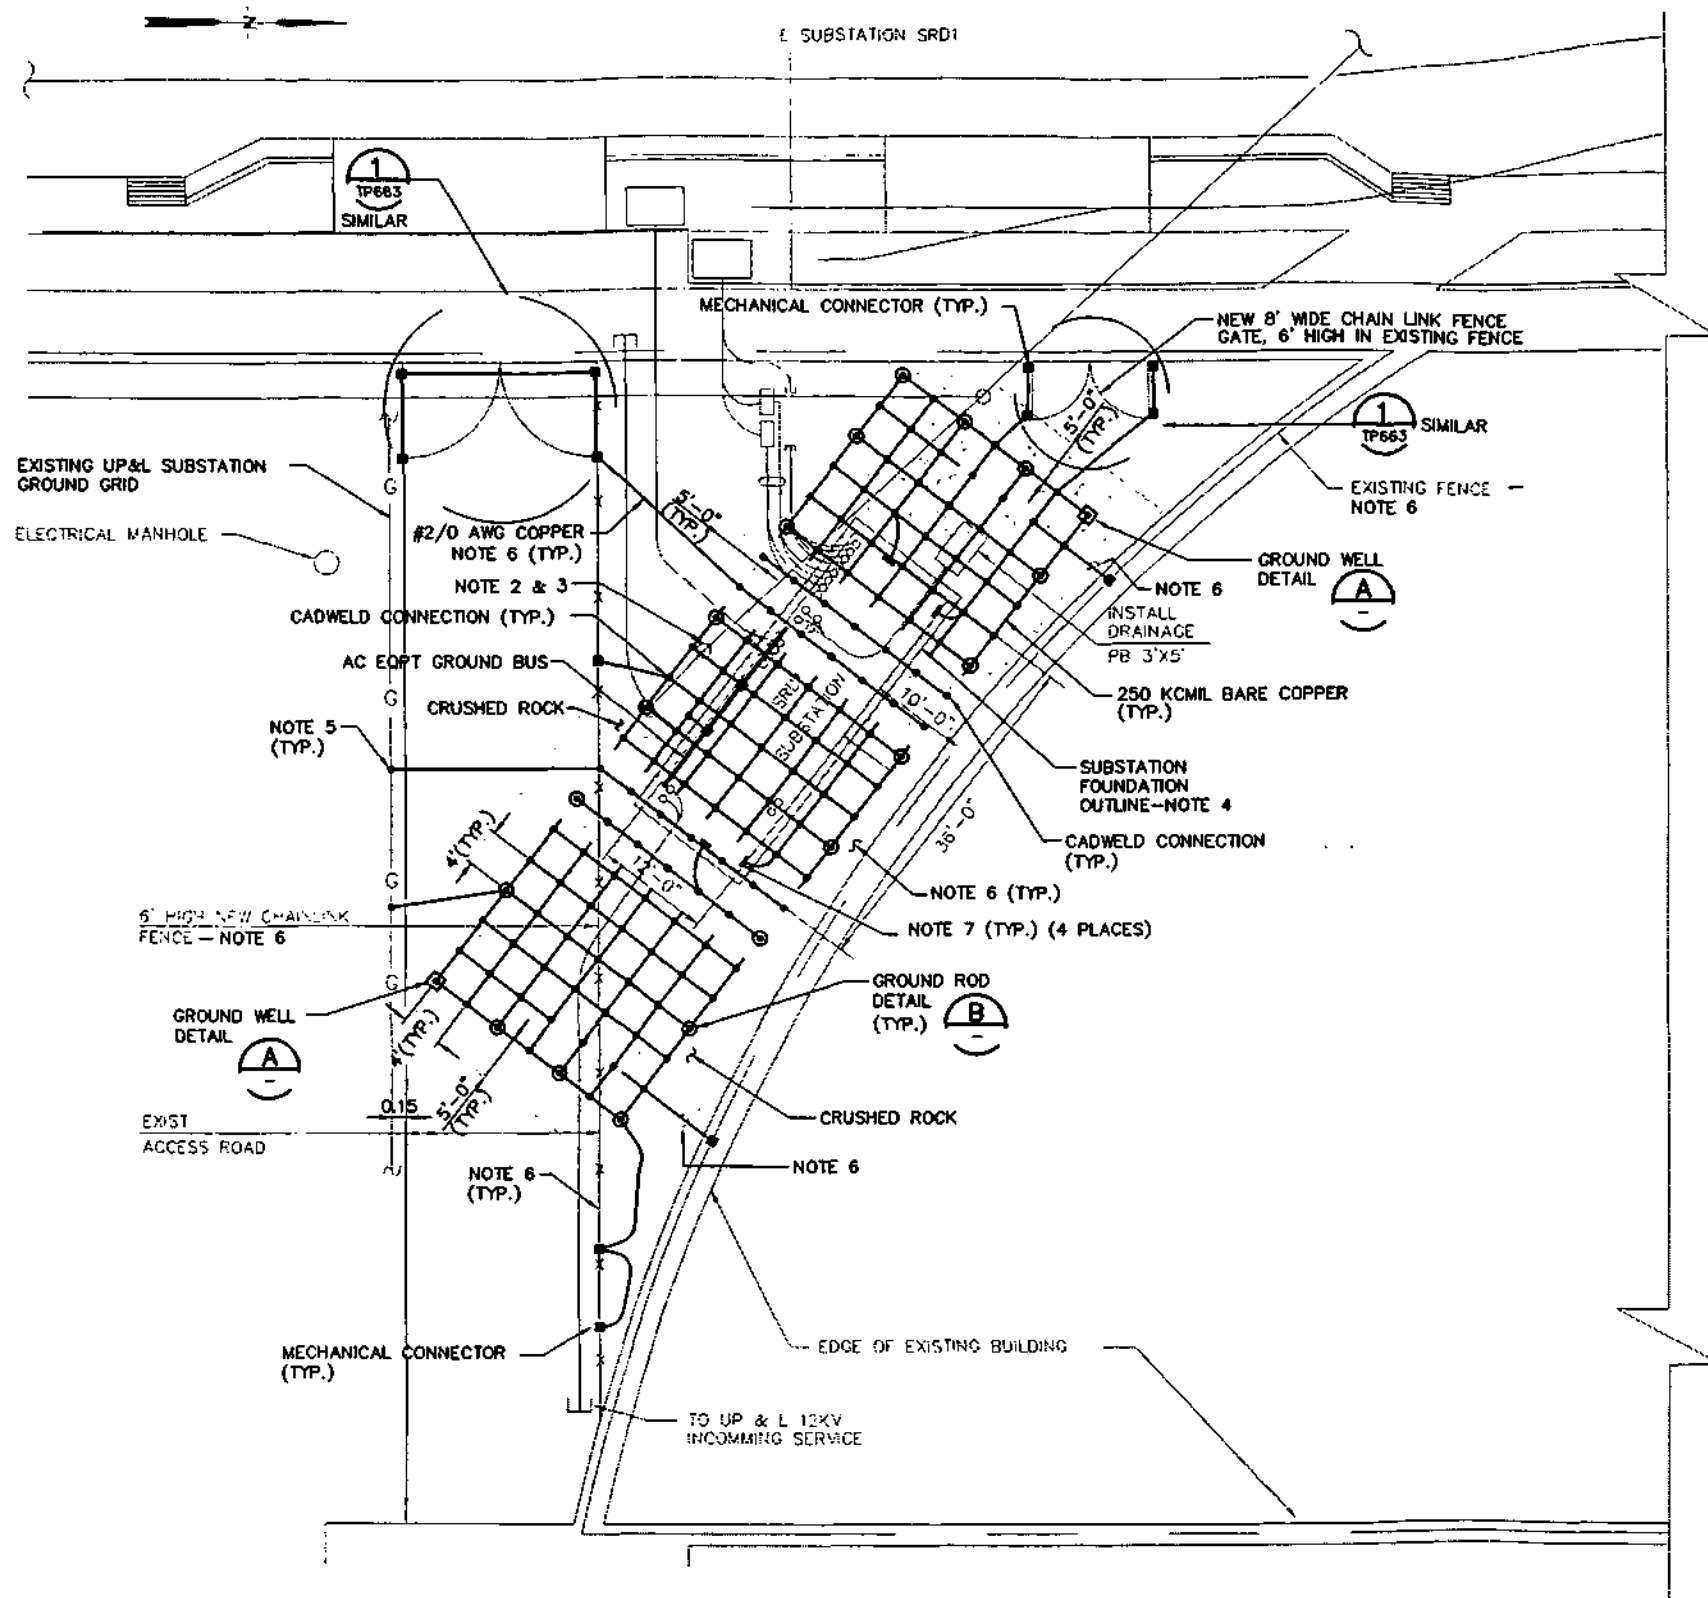


GROUNDING PLAN - SUBSTATION SRD1
SCALE: 1"=10'-0"

NOTES:

1. MAIN GROUND GRID MAT SHALL CONSIST OF 250MCM AWG BARE COPPER CONDUCTORS BURIED 2'-6" BELOW FINISHED GRADE. AC EQUIPMENT GROUND BUS SHALL BE CONNECTED TO MAIN GROUND GRID WITH 250MCM AWG COPPER CABLE.
2. BOND EXISTING DOWN GUY TO GROUND GRID WITH #4/0 AWG BARE COPPER.
3. INSTALL PVC SCHED 40 SPLIT SLEEVE CONDUIT OVER EXISTING DOWN GUY. SLEEVE SHALL EXTEND FROM GROUND LEVEL TO 6 FEET BEYOND ROOF OF SUBSTATION.
4. FOR FOUNDATION DETAILS, SEE DRAWING TP661.
5. CONTRACTOR SHALL FIELD VERIFY THE LOCATION OF EXISTING UP&L SUBSTATION GROUND GRID SYSTEM LOCATED BELOW GRADE. CONNECT NEW GROUND GRID TO THE EXISTING GRID USING 250MCM AWG COPPER CONDUCTORS VIA CADWELD CONNECTIONS.
6. CONTRACTOR SHALL GROUND ALL FENCE POSTS, GATE POSTS, FENCE SECTIONS USING #2/0 AWG GROUND WIRE AND CONNECT TO NEW GROUND GRID USING CADWELD CONNECTIONS FOR EXISTING AND NEW CHAIN LINK FENCES.
7. PROVIDE 10' LONG 250MCM COPPER BARE WIRE PIGTAILS ROUTED THROUGH SLAB FOR CONNECTIONS TO GROUNDING PADS INSIDE SUBSTATION.

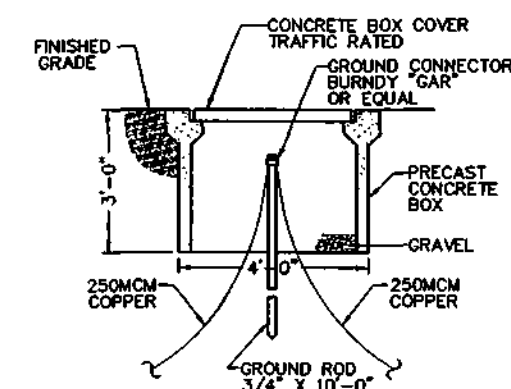


GROUND WELL DETAIL (A)
N.T.S.

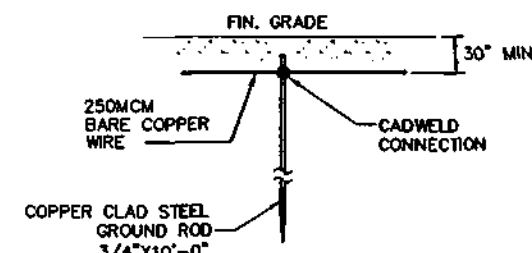

GROUND ROD DETAIL (B)
N.T.S.

REV	DATE	Description
1	9/11/02	AS-BUILT MARK UP BY UTA
2	8/23/97	ISSUED FOR CONSTRUCTION

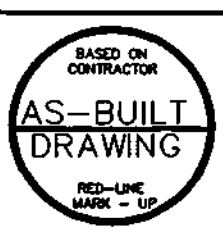

PGE Wong Engineering, Inc.
 San Francisco, California
 Submitted By: _____

UTATRAX
 SALT LAKE BUS/RAIL PROJECT
 UTAH TRANSIT AUTHORITY
 Approved By: _____

Designed By:	N.K. SOOD
Drawn By:	C.M. WONG
Checked By:	
Approved By:	

TRACTION POWER AND SIGNALING
 DELTA CENTER SUBSTATION
 GROUNDING PLAN
 SUBSTATION SRD1

Scale:	1"=10'-0"
CADD Filename:	L54TP750
Submitted Date:	JULY 7, 1997
UTA Control No:	UT-17VT-L54
Drawing No:	TP750
Sheet No:	201A



UTAH TRANSIT AUTHORITY

SALT LAKE BUS/RAIL PROJECT

SALT LAKE CITY, UTAH

APRIL 2003

TRACTION POWER SUBSTATION — PROCUREMENT

CONTRACT NUMBER: UT-11VT-L35



Civil Final Design



PGH Wong Engineering, Inc.
San Francisco, California


AS-BUILT
RECORD DRAWINGS

DOCUMENT 1 of 1

L:\North-South As-Built\CAU Work\As-Built Submittal April 2003\L35\L35tp500.dwg, 06/23/2003 03:41:32 PM, csiama, Carlee S

PROJECT CONTROL DATE: 10/08/97 15:40:00 CAD FILENAME: C:\UTA\135tp500.DWG (314) OF/DWL PLOTTED SCALE: 1=1'00"

INDEX OF DRAWINGS									
SHEET No	DWG No	TITLE	REV	SHEET No	DWG No	TITLE	REV		
		GENERAL							
	--	LOCATION PLAN							
1	TP500	INDEX OF DRAWINGS							
		TRACTION POWER SUBSTATION PROCUREMENT							
2	TP501	SYMBOLS AND ABBREVIATIONS							
3	TP502	MASTER SINGLE-LINE DIAGRAM SHEET 1 OF 4							
4	TP503	MASTER SINGLE-LINE DIAGRAM SHEET 2 OF 4							
5	TP504	MASTER SINGLE-LINE DIAGRAM SHEET 3 OF 4							
6	TP505	MASTER SINGLE-LINE DIAGRAM SHEET 4 OF 4							
7	TP506	TYPICAL SINGLE-LINE SUBSTATION METER AND RELAY DIAGRAM							
8	TP507	TYPICAL SINGLE-LINE SUBSTATION YRY1 METER AND RELAY DIAGRAM							
9	TP509	ANNUNCIATOR WINDOW ARRANGEMENT							
10	TP510	TYPICAL SUBSTATION EQUIPMENT ARRANGEMENT SUBSTATIONS AT GRADE LEVEL AND YRY1							
11	TP512	TYPICAL SUBSTATION SECTIONS							
12	TP514	SUBSTATION EQUIPMENT ARRANGEMENT UNDERGROUND VAULT SUBSTATION SRT2							
		AS-BUILT MARK UP BY UTA							
		ISSUED FOR CONSTRUCTION							
REV	DATE	Description							




UTAH TRAX
SALT LAKE BUS/RAIL PROJECT
UTAH TRANSIT AUTHORITY

Designed By:	R.C. DHINGRA
Drawn By:	C.M. WONG
Checked By:	E.J. ROWE
Approved By:	J.M. KATZ

TRACTION POWER SUBSTATION PROCUREMENT SYMBOLS AND ABBREVIATIONS

Sooter NTS	
CADD #/Name: L35TP501	
Submittal Date: 12/23/98	
UFA Contract No.: UT-11VT-L35	
Breeding No.: TP501	Sheet #: 2

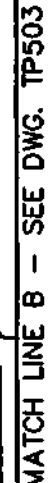

 <p>UTA TRAX SALT LAKE BUS/RAIL PROJECT UTAH TRANSIT AUTHORITY</p>	Designed By:	R.C. DINGMIRE
	Drawn By:	D.S. TALLITICH
	Checked By:	E.J. ROWE
	Approved By:	J.M. KATZ
	Approved By:	
	Approved By:	

<p align="center">TRACTION POWER SUBSTATION</p> <p align="center">PROCUREMENT</p> <p align="center">MASTER SINGLE-LINE DIAGRAM</p> <p align="center">SHEET 1 OF 4</p>	Sooner NTS	
	CADD Filename: L35TP502	
	Submittal Date 12/23/96	
	UTA Contract No.: UT-11V7-L35	
	Drawing No.: TP502	Sheet No.: 3


PROJECT CONTROL DATE: 10/08/97 16:05:00 CAD FILENAME: C:\UTA\3510503.DWG (C15) DF/DHL PLOTTED SCALE: 1=500'-0"

MATCH LINE B - SEE DWG. TP502


MATCH LINE C - SEE ABOVE

MATCH LINE C - SEE BELOW

MATCH LINE D - SEE DWG. TP504

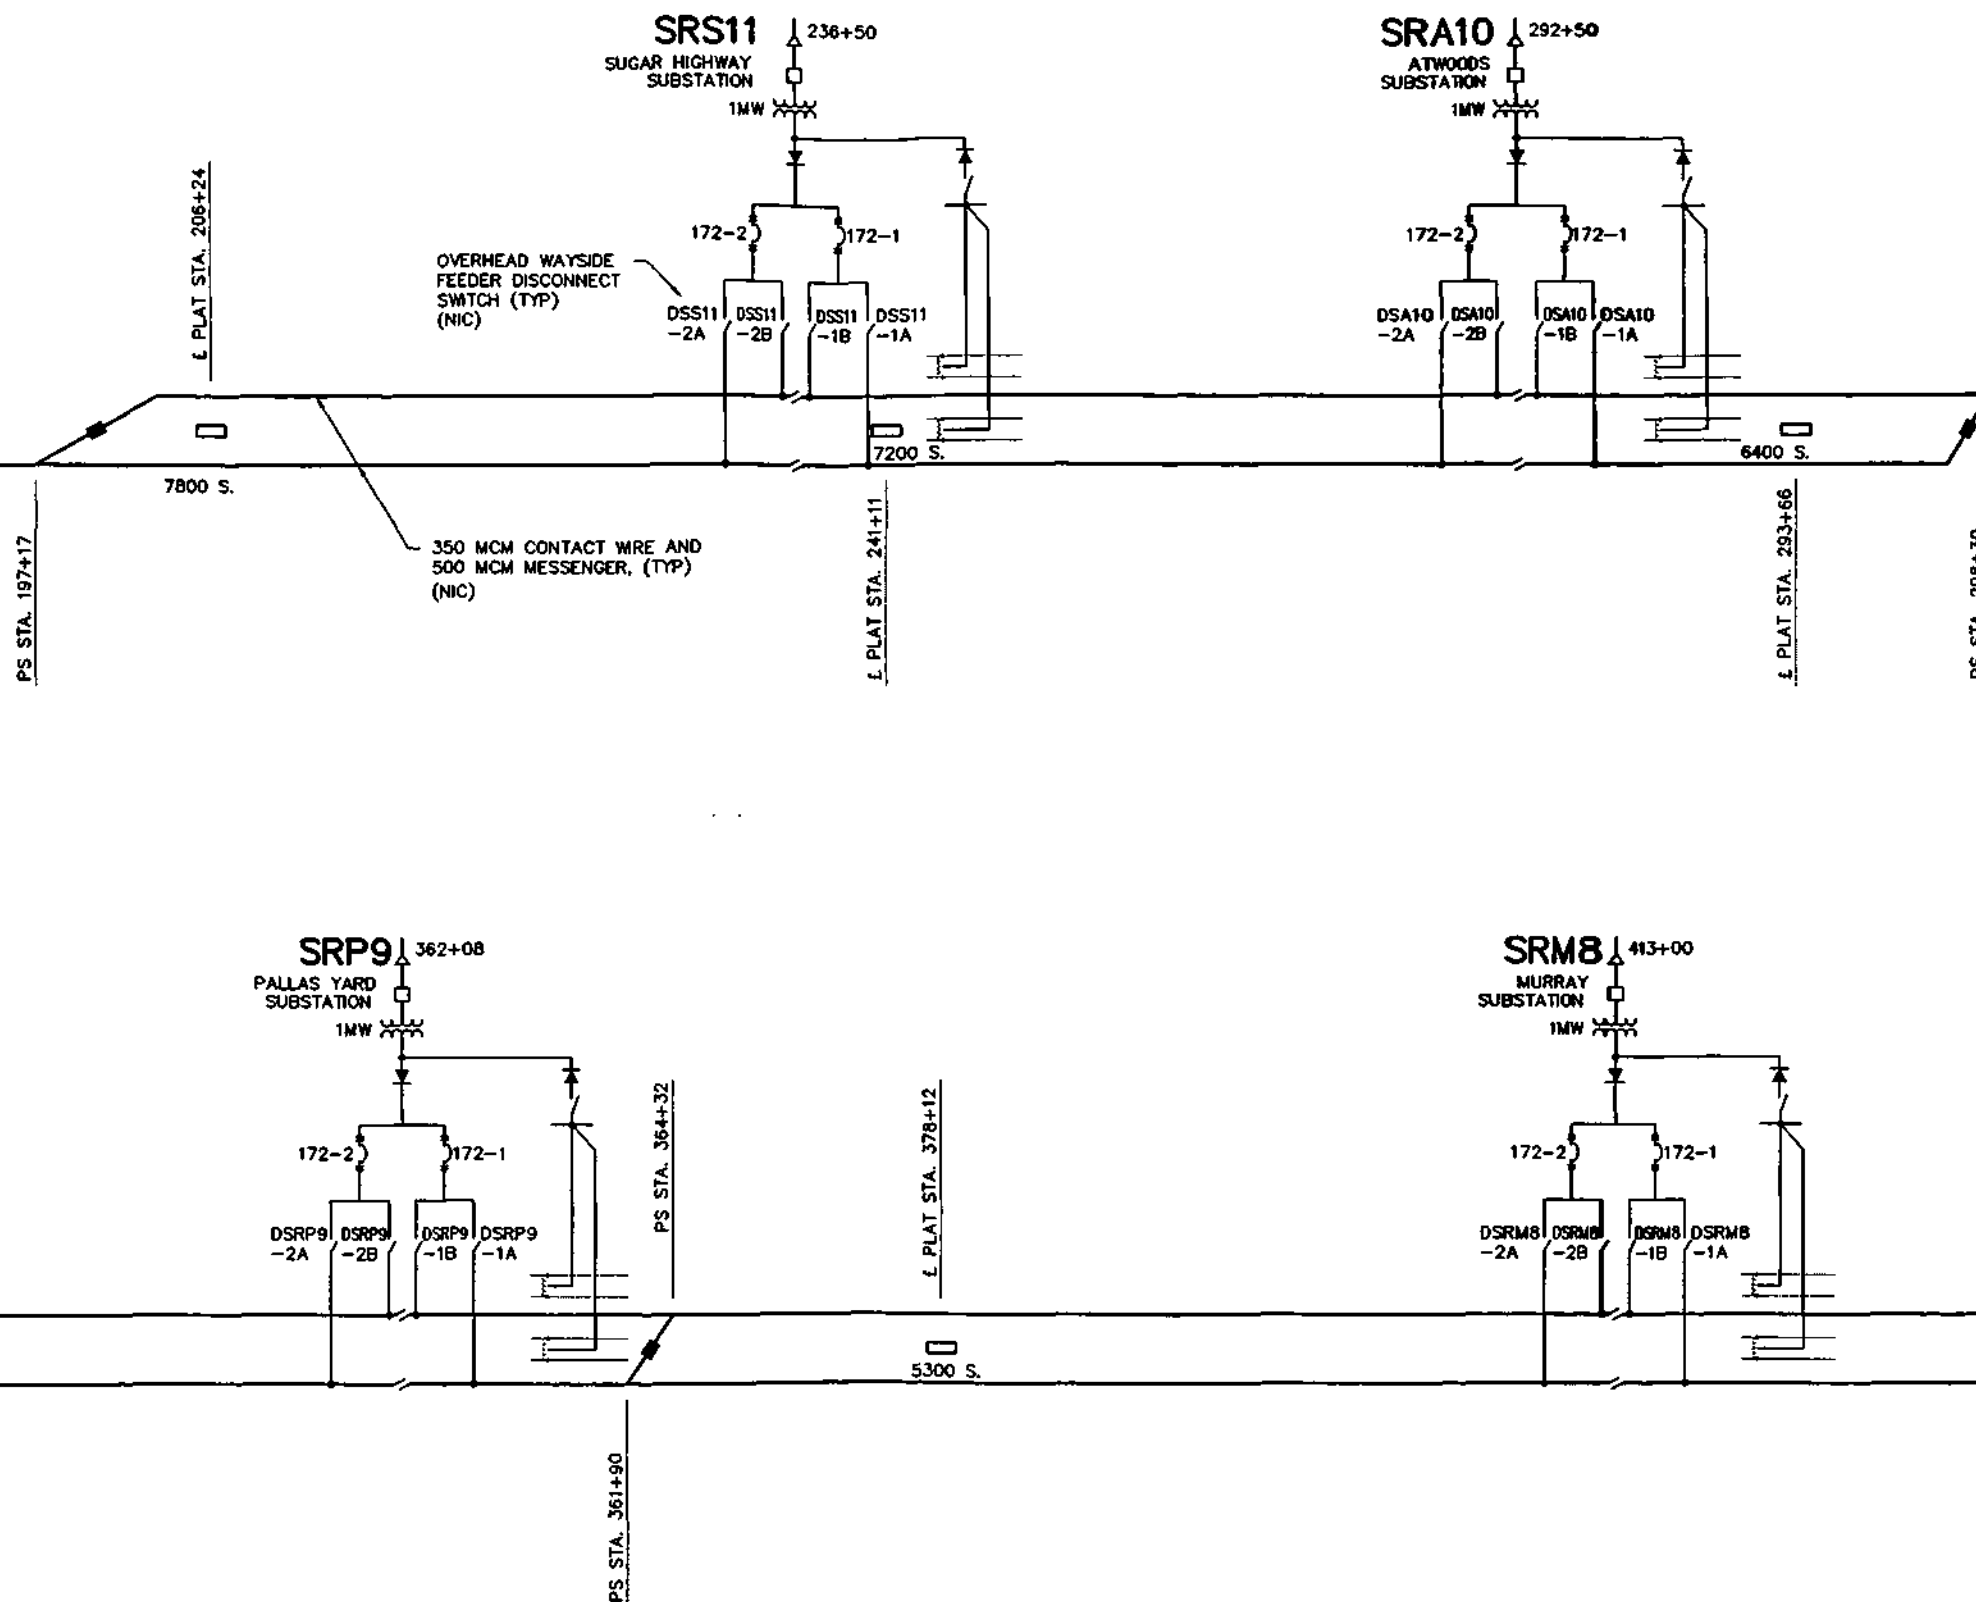

REV	DATE	Description
1	11/11/02	AS-BUILT MARK UP BY UTA
2	4/15/97	ISSUED FOR CONSTRUCTION

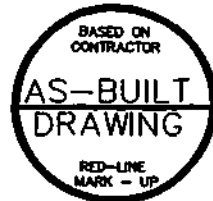

Submitted By: _____

PGH Wong Engineering, Inc.
San Francisco, California

UTA TRAX
SALT LAKE BUS/RAIL PROJECT
UTAH TRANSIT AUTHORITY

Approved By: _____

Designed By:	R.C. DHINGRA
Drawn By:	D.S. TALLITSCH
Checked By:	E.J. ROWE
Approved By:	J.N. KATZ

**TRACTION POWER SUBSTATION
PROCUREMENT**

MASTER SINGLE-LINE DIAGRAM
SHEET 2 OF 4

Scale:	NTS
CADD Filename:	L35TP503
Submitted Date:	12/23/98
UTA Contract No.:	UT-11VF-L35
Drawing No.:	TP503
Sheet No.:	4


L:\North-South As-Built\CAD Work\As-Built Submittal April 2003\L35\L35tp504.dwg, 06/23/2003 05:42:04
PROJECT CONTROL DATE: 10/08/97 16:06:25 CAD FILENAME: C:\UT\A\35\tp504.dwg (015) OF/DHL PLOTTED SCALE: 1=500'-0"

MATCH LINE D - SEE DWG. TP503


MATCH LINE E - SEE ABOVE

MATCH LINE E - SEE BELOW

MATCH LINE F - SEE DWG. TP505

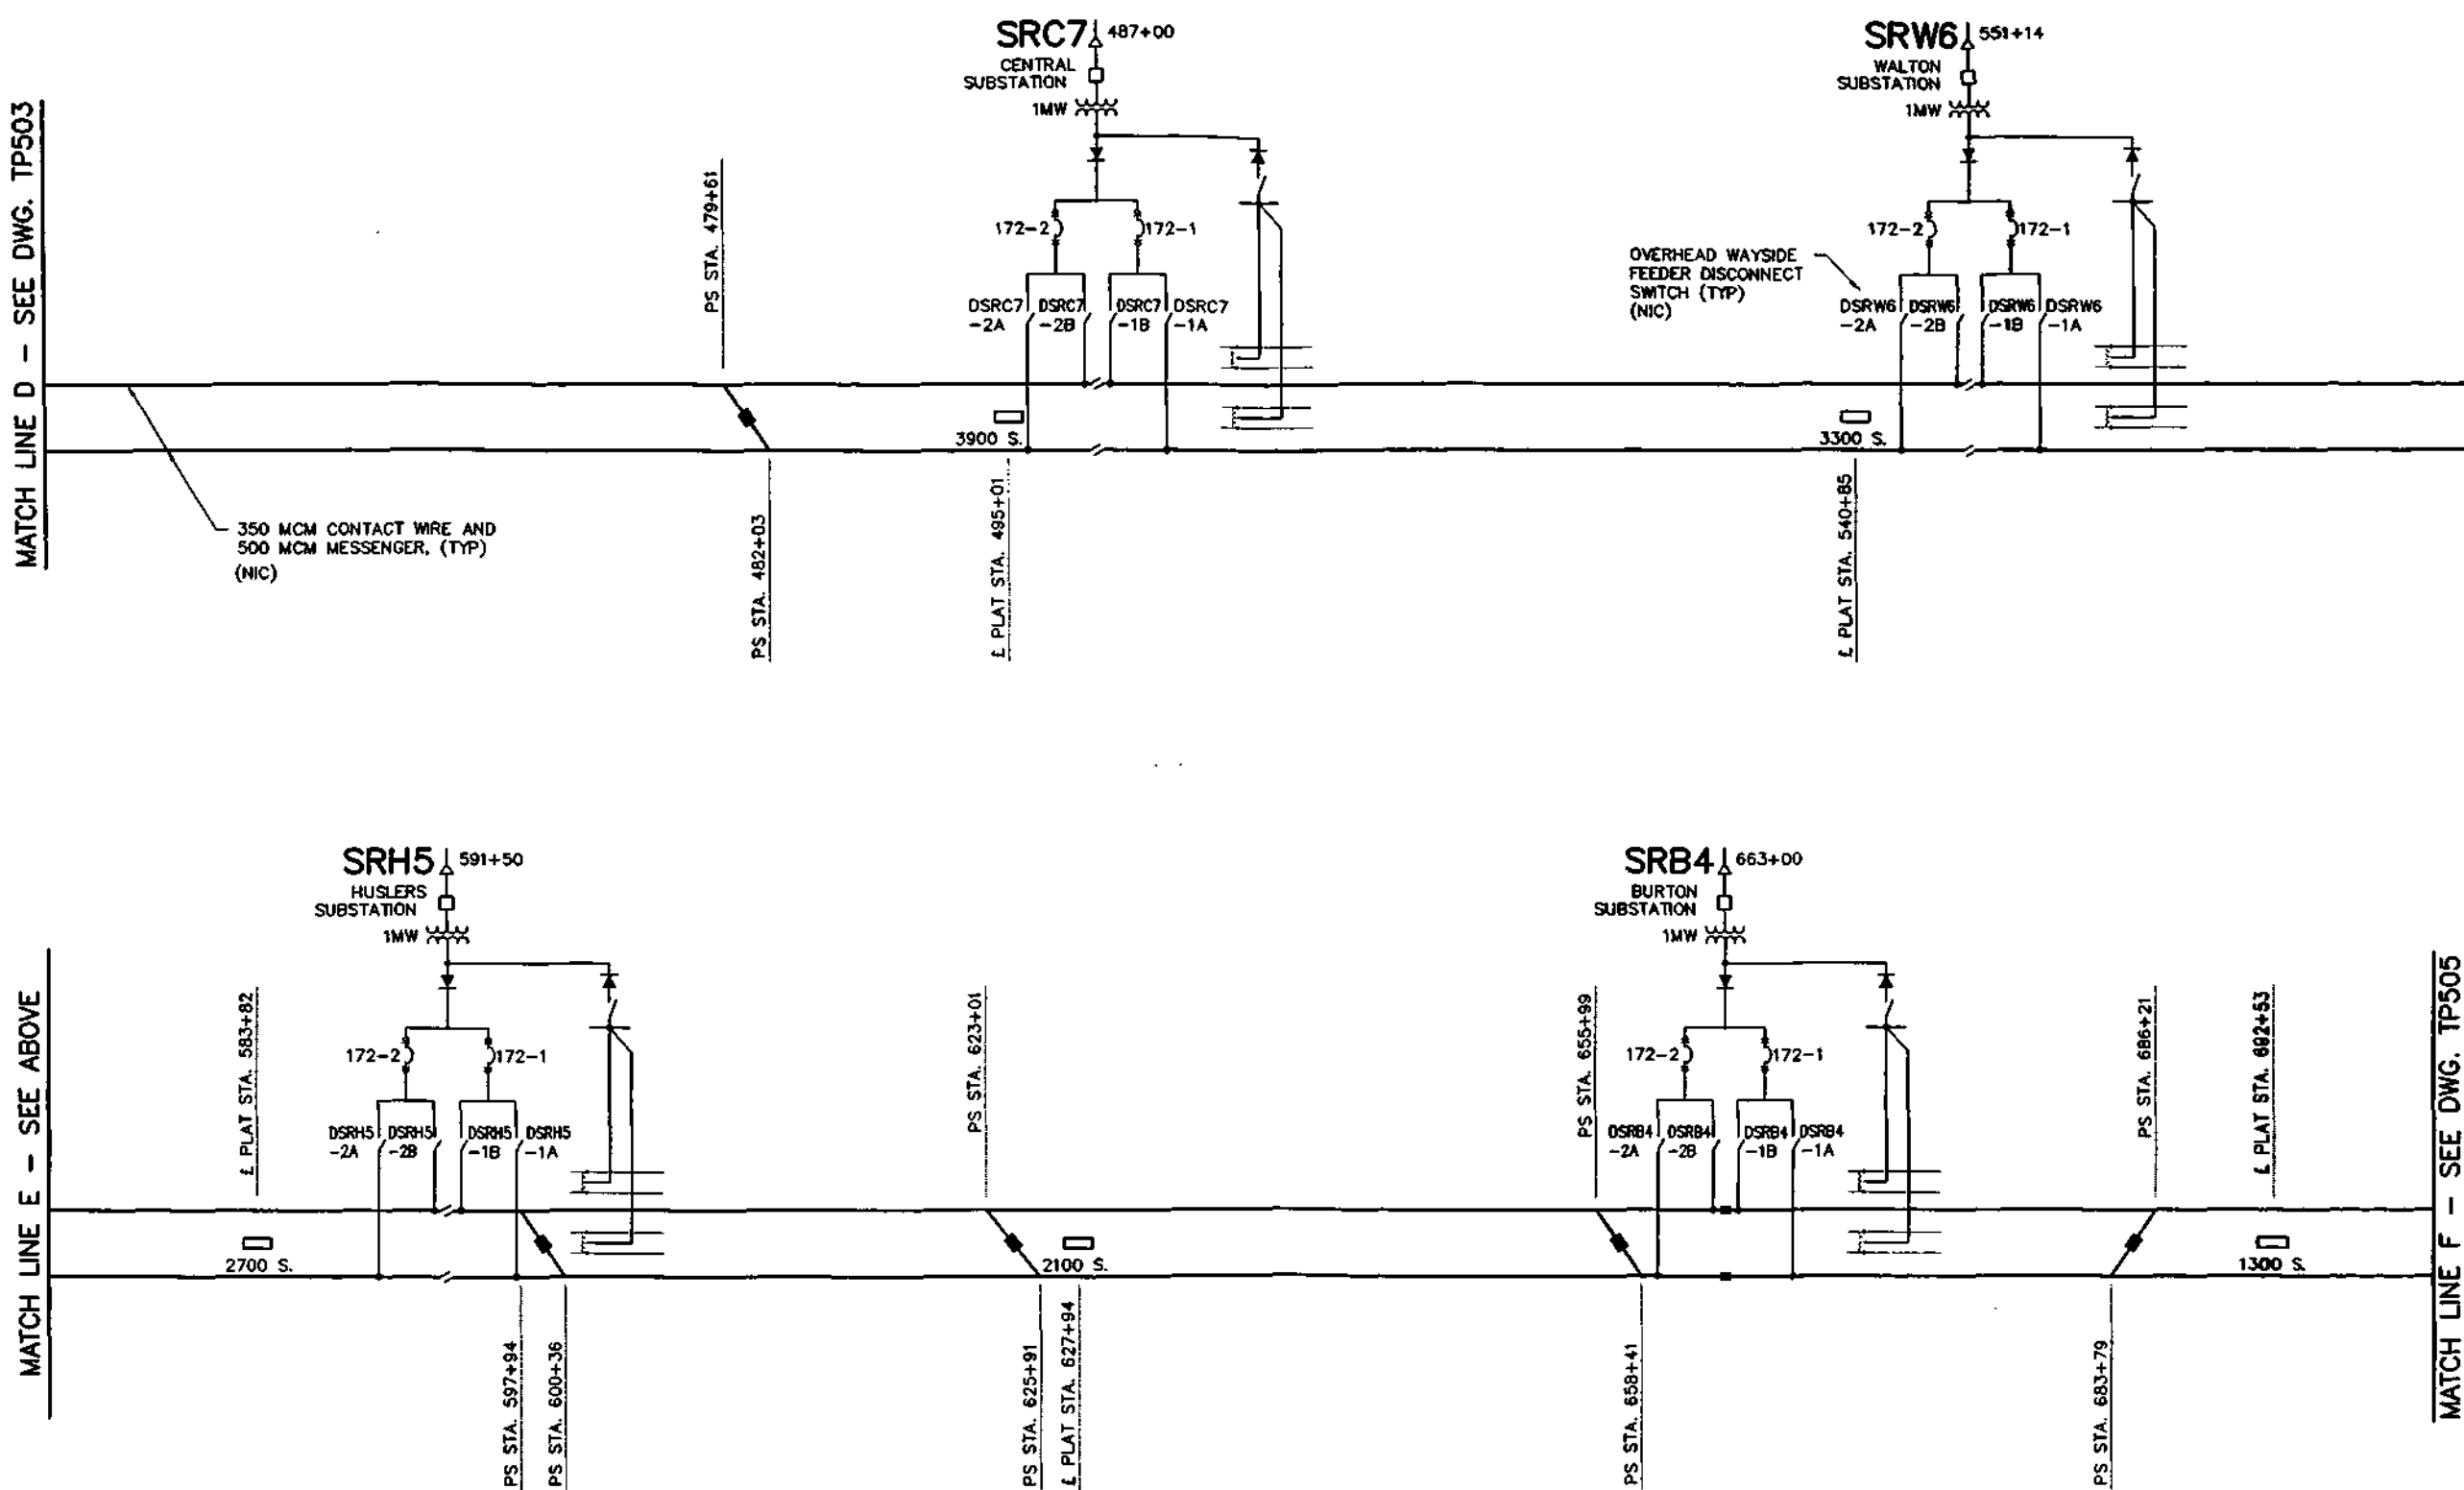

REV	DATE	Description
1	11/11/02	AS-BUILT MARK UP BY UTA
2	4/15/97	ISSUED FOR CONSTRUCTION

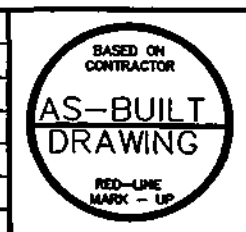

Submitted By: PGB Wong Engineering, Inc. San Francisco, California

Approved By: UTA TRAX SALT LAKE BUS/RAIL PROJECT UTAH TRANSIT AUTHORITY

Designed By:	R.C. DHINGRA
Drawn By:	D.S. TALUTSCH
Checked By:	E.J. ROWE
Approved By:	J.H. KATZ


TRACTION POWER SUBSTATION PROCUREMENT MASTER SINGLE-LINE DIAGRAM SHEET 3 OF 4

Drawn By:	Sheet No.:
12/23/96	5


L:\North-South As-Built\CAD Work\As-Built Submittal April 2003\L35\L35tp505.dwg, 06/23/2003 03:42:12 cs:ama, Carlee S

PROJECT CONTROL DATE: 10/08/97 16:10:00 CAD FILENAME: C:\UTA\L35\505.DWG (C15) DF/DWL PLOTTED SCALE: 1"=500'-0"

MATCH LINE F - SEE DWG. TP504

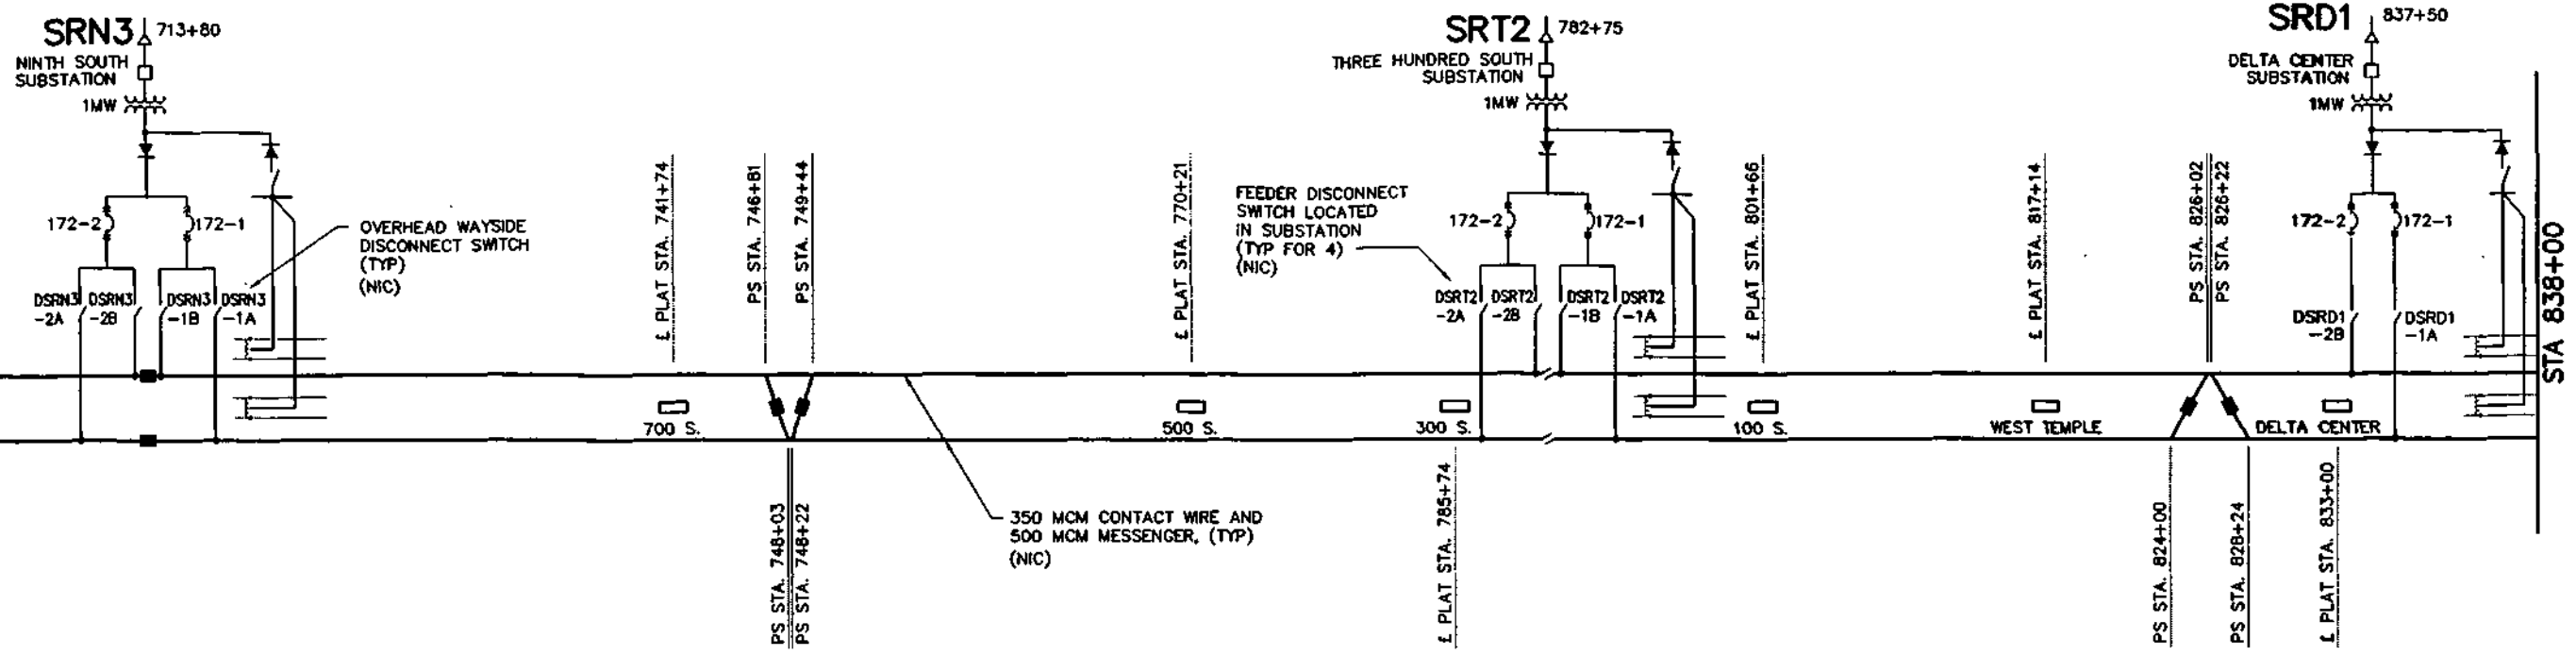

REV	DATE	DESCRIPTION
1	11/11/02	AS-BUILT MARK UP BY UTA
2	4/15/97	ISSUED FOR CONSTRUCTION

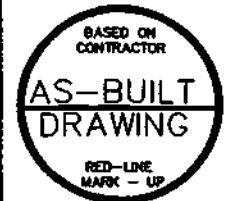


PGH Wong Engineering, Inc.
San Francisco, California

UTA TRAX
SALT LAKE BUS/RAIL PROJECT
UTAH TRANSIT AUTHORITY

Designed By:	R.C. DHINGRA
Drawn By:	D.S. TALLITSCH
Checked By:	E.J. ROWE
Approved By:	J.H. KATZ

TRACTION POWER SUBSTATION
PROCUREMENT
MASTER SINGLE-LINE DIAGRAM
SHEET 4 OF 4

Scale:	NTS
CADD Filename:	L35TP505
Submitted Date:	12/23/96
UTA Contract No.:	UT-11VT-L35
Drawing No.:	TP505
Sheet No.:	6

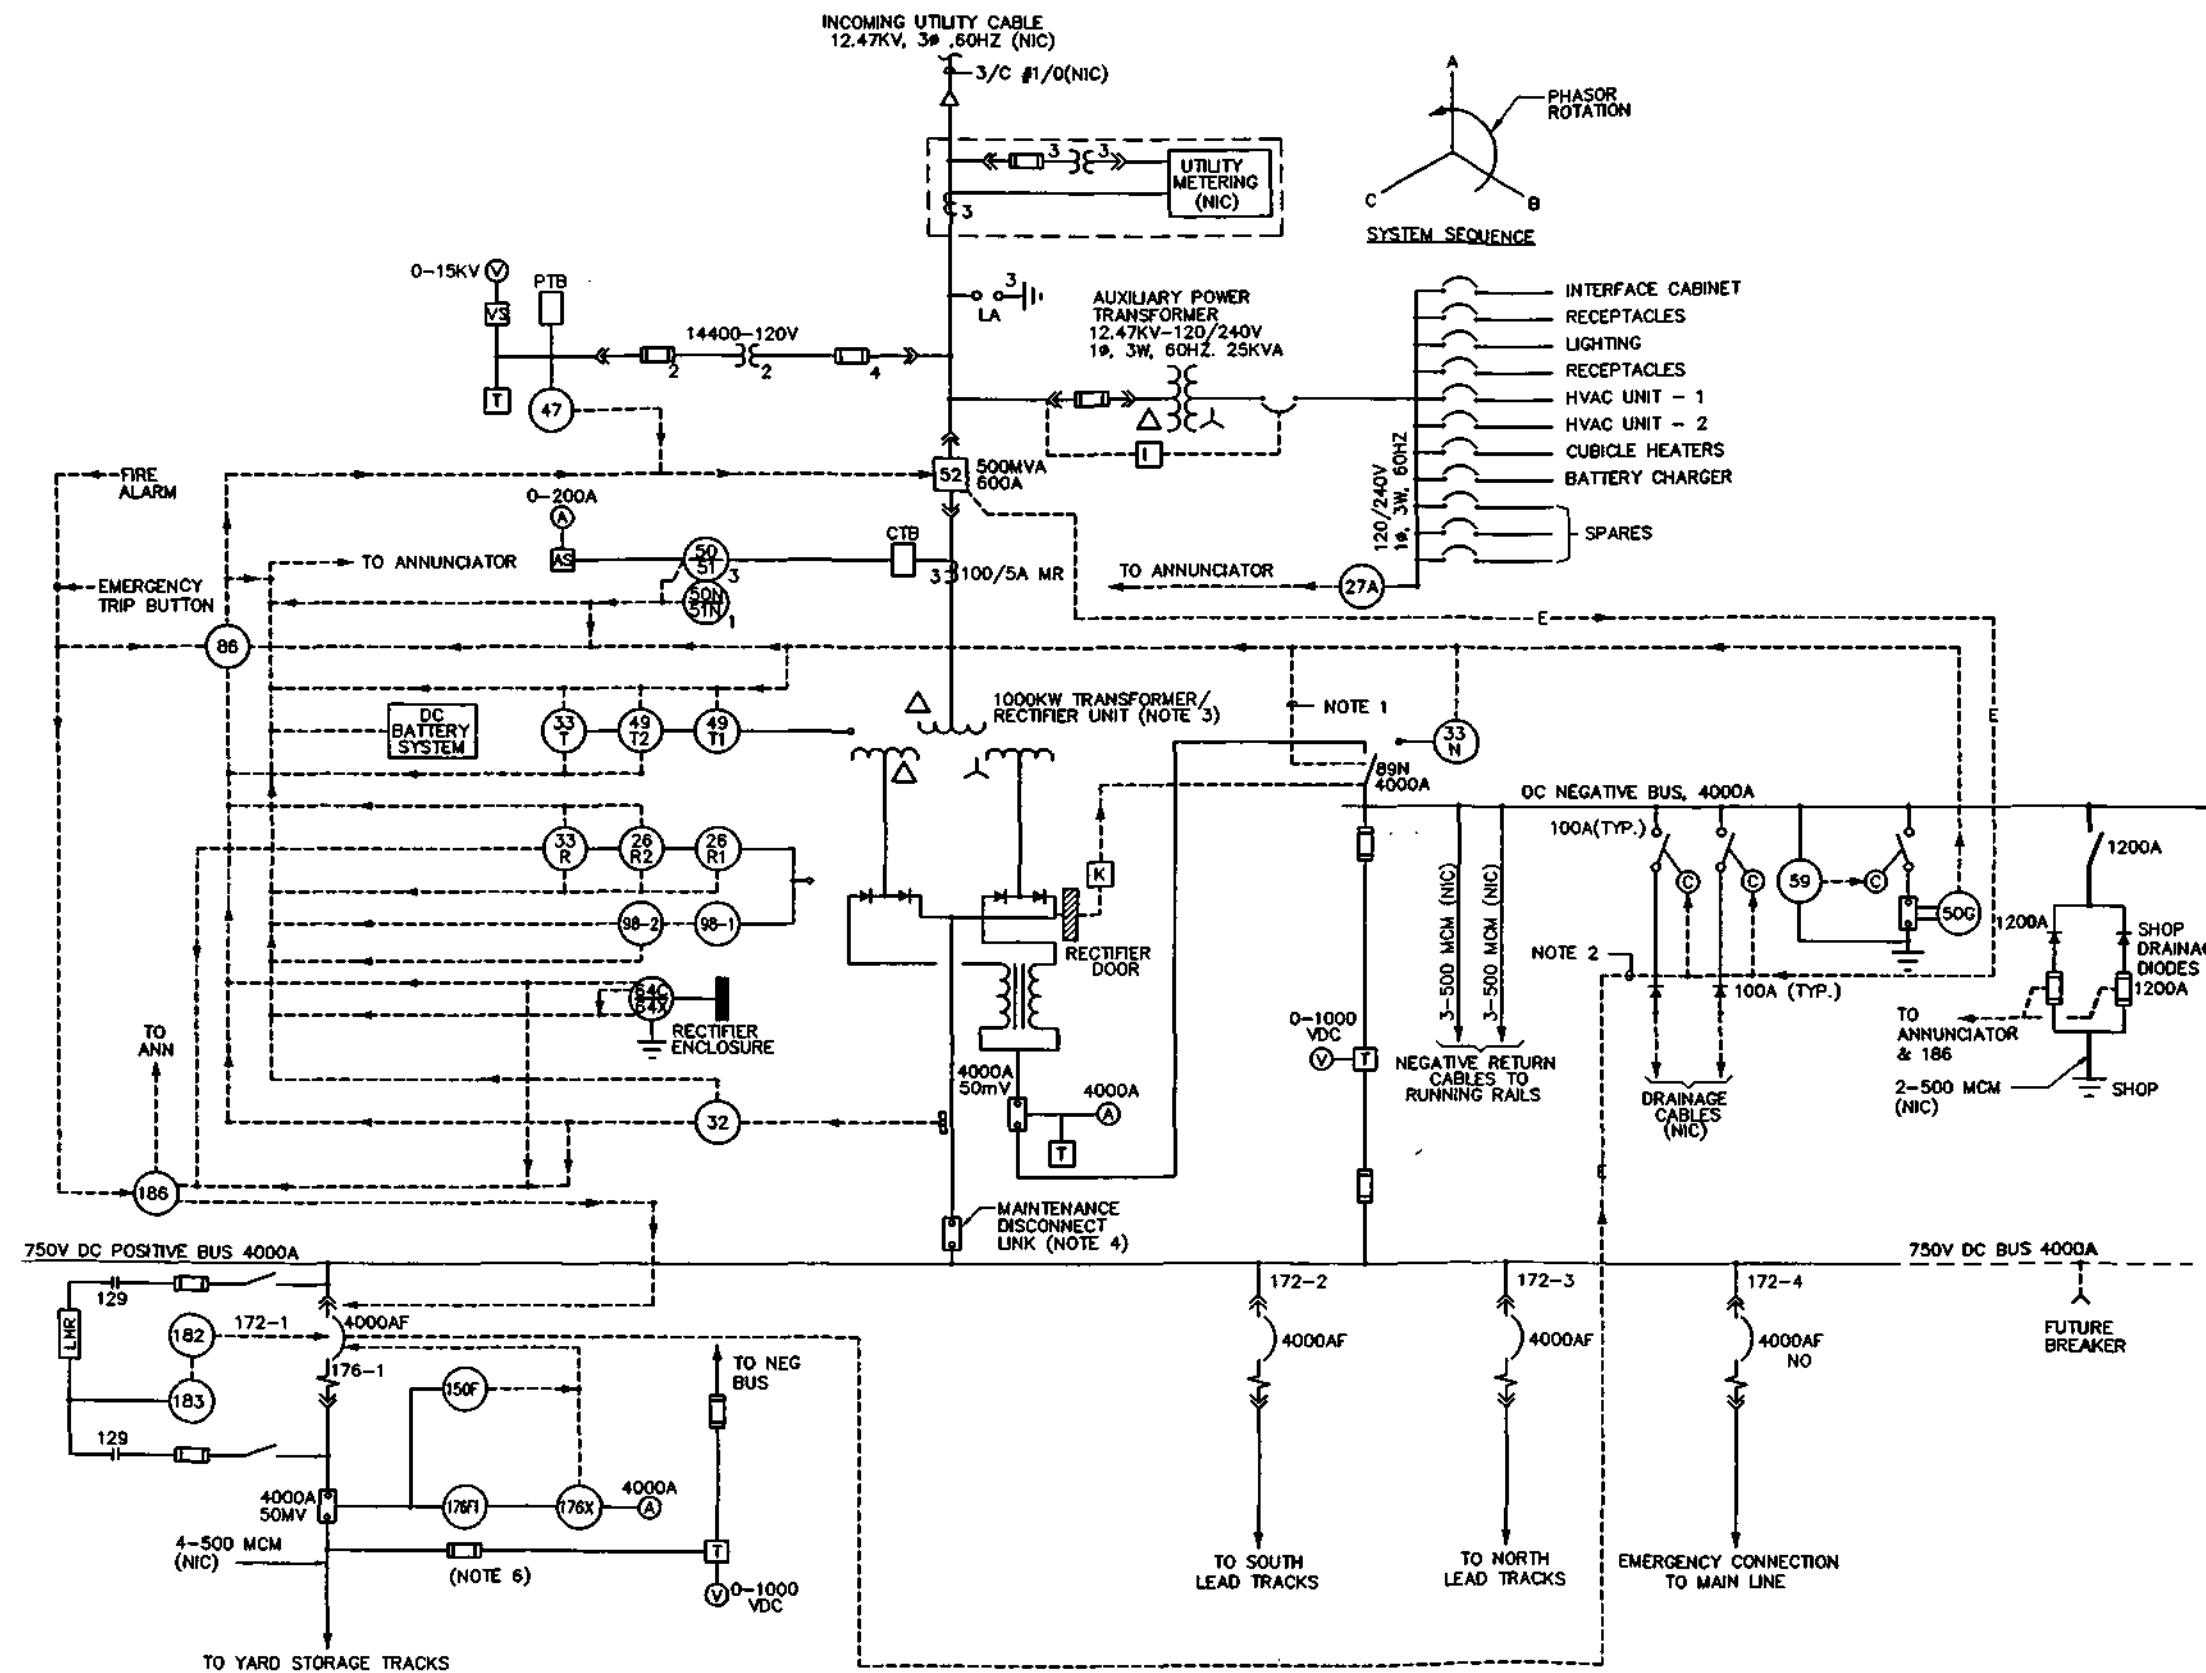


NOTES:

1. AC CIRCUIT BREAKER 52 SHALL BE ELECTRICALLY INTERLOCKED WITH SWITCH 89N.
2. NEGATIVE DRAINAGE CONTACTORS SHALL BE IN CLOSED POSITION WHEN THE FOLLOWING CONDITIONS ARE SATISFIED:
 - AC BREAKER 52 CLOSED
 - DC BREAKER 172-1 AND/OR 172-2 CLOSEDCONTACTORS SHALL OPEN WHEN ANY OF THESE CONDITIONS ARE NOT SATISFIED.
3. 1000KW TRANSFORMER/RECTIFIER SHOWN ON THE DWG. OPTION REQUIRES 1500KW TRANSFORMER/RECTIFIER.
4. MAINTENANCE LINK TO BE READILY ACCESSIBLE IN THE RECTIFIER CUBICLE.
5. GROUNDING CONTACTOR TO BE LOCATED IN THE NEGATIVE CUBICLE.
6. DC METERING AND RELAYING SCHEME SHOWN FOR ONE DC CIRCUIT BREAKER TYPICAL FOR ALL.

DEVICE TABLE

DEVICE	DESCRIPTION	REMARKS
26R1	RECTIFIER DIODE OVERTEMP. 1ST STAGE	ANN
26R2	RECTIFIER DIODE OVERTEMP. 2ND STAGE	TRIP
27A	STATION SERVICE POWER: LOSS OF VOLTAGE	
27D	DRAINAGE PANEL CONTROL CIRCUIT: LOSS OF VOLTAGE	(NOT SHOWN IN DIAG.)
27R	RECTIFIER CONTROL CIRCUIT: LOSS OF DC CONTROL POWER	(NOT SHOWN IN DIAG.)
27F1	DC BKR 172-1: LOSS OF DC CONTROL POWER	(NOT SHOWN IN DIAG.)
27F2	DC BKR 172-2: LOSS OF DC CONTROL POWER	(NOT SHOWN IN DIAG.)
32	REVERSE CURRENT INSTANTANEOUS RELAY	TRIP
33N	DOOR SWITCH (NEGATIVE DISC. SW.)	TRIP
33R	DOOR SWITCH (RECTIFIER ENCLOSURE)	TRIP
33T	DOOR SWITCH (TRANSFORMER ENCLOSURE)	TRIP
47	PHASE SEQUENCE VOLTAGE RELAY	TRIP
49T1	TRANSFORMER WINDING OVERTEMP. 1ST STAGE	ANN
49T2	TRANSFORMER WINDING OVERTEMP. 2ND STAGE	TRIP
50/51	INSTANTANEOUS & TIME OVERCURRENT RELAY, PHASE	TRIP
50N/51N	INSTANTANEOUS & TIME OVERCURRENT RELAY, NEUTRAL	TRIP
50G	GROUND RETURN OVERCURRENT RELAY	TRIP
52	AC CIRCUIT BREAKER	
59	VOLTAGE RELAY	
64C	DC SWITCHGEAR & RECTIFIER ENCLOSURE ALIVE	TRIP
64X	DC SWITCHGEAR & RECTIFIER ENCLOSURE GROUNDED	ANN
86	LOCKOUT RELAY	
89	HIGH VOLTAGE AC LOAD INTERRUPTER SWITCH	
89N	RECTIFIER NEGATIVE DISCONNECT SWITCH	
98-1	RECTIFIER FIRST DIODE FAILED	ANN
98-2	RECTIFIER SECOND DIODE FAILED	TRIP
129	DC FEEDER LOAD MEASURING CONTACTOR	
150F	DC FEEDER RATE OF RISE RELAY	
172	DC FEEDER BREAKER	
176	DC FEEDER INSTANTANEOUS SERIES TRIP DEVICE	
176F	DC FEEDER INSTANTANEOUS OVERCURRENT RELAY	
176X	DC FEEDER AUXILIARY TIMING RELAY FOR 176F	
182	DC FEEDER LOAD MEASURING RECLOSING RELAY	
183	DC FEEDER & TRACTION SYSTEM VOLTAGE SENSING RELAY	TRIP
186	DC FEEDER LOCKOUT RELAY	
LMR	LOAD MEASURING RESISTOR	

REV	DATE	DESCRIPTION
1	11/11/02	AS-BUILT MARK UP BY UTA
2	4/15/97	ISSUED FOR CONSTRUCTION

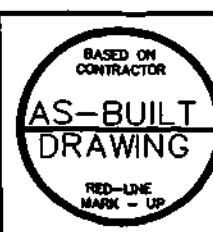

Designed By:	R.C. DHINGRA
Drawn By:	C.M. WONG
Checked By:	E.J. ROWE
Approved By:	J.M. KATZ

TRACTION POWER SUBSTATION PROCUREMENT TYPICAL SINGLE-LINE SUBSTATION YRY1 METER AND RELAY DIAGRAM
--

Scale:	NTS
CADD File:	L35TP507
Submitted Date:	12/23/02
UTAH Contract No.:	99-TFOT-435
Drawing No.:	TP507
Sheet No.:	8

L:\North-South As-Built\CAD Work\As-Built Submittal April 2003\L35\tp509.dwg, 06/25/2003 03:44:10 PM, cslamo, Carlee S

LOCKOUT RELAY TRIP 86 1	DC FEEDER LOCKOUT RELAY TRIP 186 2	AC MAIN CIRCUIT BREAKER TRIP 52 3	AC OVERCURRENT TRIP 50, 51, 50N, 51N 4	NORTH TRACK DC FEEDER BREAKER TRIP 172-1 5	SOUTH TRACK DC FEEDER BREAKER TRIP 172-2 6
TRANSFORMER WINDING OVERTEMP TRIP 49T2 7	TRANSFORMER WINDING OVERTEMP ALARM 49T1 8	RECTIFIER DIODE OVERTEMP ALARM 26R1 9	RECTIFIER DIODE OVERTEMP TRIP 26R2 10	RECTIFIER FIRST DIODE FAILURE ALARM 98-1 11	RECIFIER SECOND DIODE FAILURE TRIP 98-2 12
BATTERY CHARGER FAILURE ALARM 13	DC BATTERY UNDERVOLTAGE 14	DC CONTROL CIRCUITS LOSS OF POWER 27D, 27R 27F1, 27F2 15	STATION SERVICE POWER LOSS OF VOLTAGE 27A 16	LOSS OF DC POWER SUPPLY TO 47, 51 & 51N RELAYS 17	REVERSE POWER FLOW 32 18
TRANSFORMER ACCESS DOOR OPEN 33T 19	RECTIFIER DOOR OPEN 33R 20	NEGATIVE DISC SWITCH DOOR OPEN 33N 21	SPARE 22	DC ENCLOSURE GROUNDED ALARM 64X 23	DC ENCLOSURE ALIVE TRIP 64C 24
FIRE DETECTION SYSTEM ALARM 25	FIRE DETECTION SYSTEM TROUBLE 26	SPARE 27	GROUND RETURN OVERCURRENT TRIP 50G (NOTE 1) 28	SHOP DRAINAGE FIRST DIODE FAILURE ALARM (NOTE 2) 29	SHOP DRAINAGE SECOND DIODE FAILURE TRIP (NOTE 2) 30

NOTE:
1. PROVIDE 50G ANNUNCIATION AT SUBSTATION YRY1 ONLY.
2. PROVIDE ANNUNCIATION FOR SHOP FIRST AND SECOND DIODE FAILURE AND TRIP AT SUBSTATION YRY1 ONLY.

PROJECT CONTROL DATE: 10/09/97 08:30:00 CAD FILENAME: C:\UT\AS\tp509.DWG (21) R0/DHL PLOTTED SCALE: 1=1'00"

AS-BUILT DRAWING

PGH Wong Engineering, Inc.
San Francisco, California

UTATrax

SALT LAKE BUS/RAIL PROJECT
UTAH TRANSIT AUTHORITY

Designed By:
R.C. DHINGRA

Drawn By:
C.M. WONG

Checked By:
E.J. ROWE

Approved By:
J.N. KATZ

TRACTION POWER SUBSTATION
PROCUREMENT
ANNUNCIATOR WINDOW
ARRANGEMENT

Scale:
NTS

DCD Filename:
L35TP509

Submitted Date:
12/23/98

UT Contract No.:
UT-11VT-L35

Sheet No.:
TP509

9


11/11/02 AS-BUILT MARK UP BY UTA

4/15/97 ISSUED FOR CONSTRUCTION

REV	DATE	DESCRIPTION

Submitted By: _____

Approved By: _____

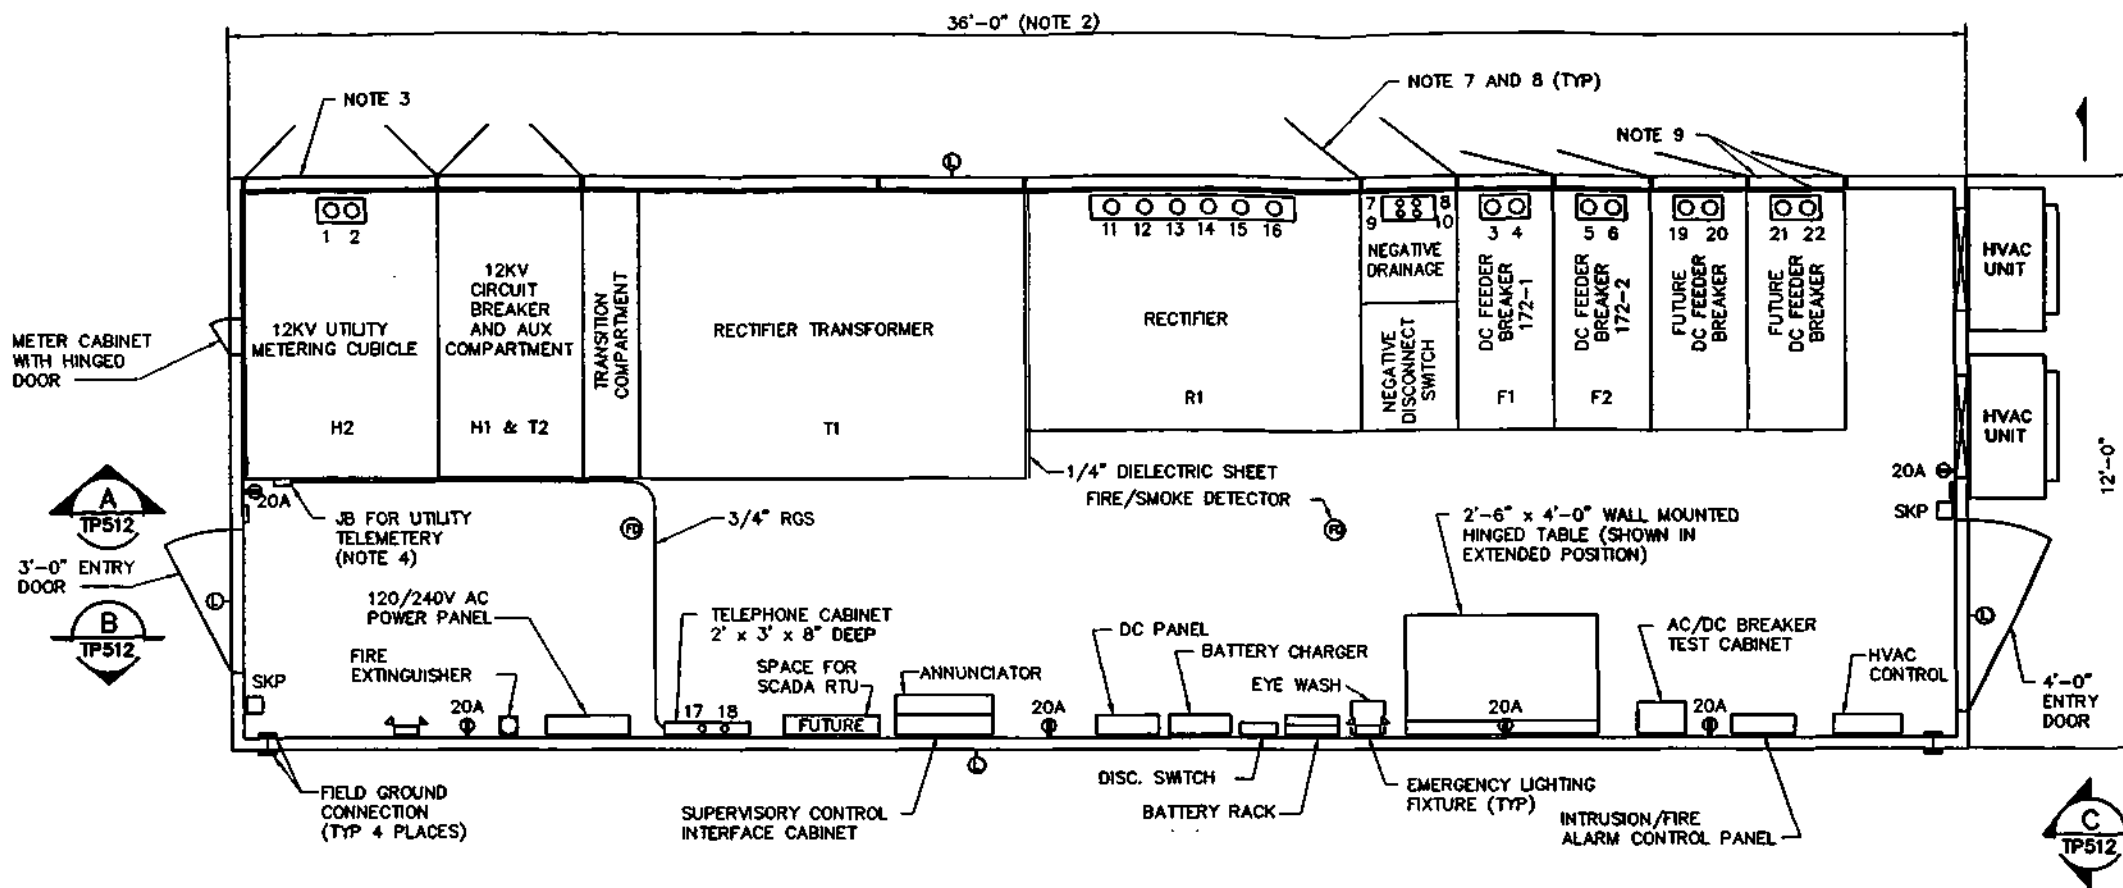

SYMBOL	DESCRIPTION
H2	METERING CUBICLE
H1	12KV BREAKER CUBICLE
T1	RECTIFIER TRANSFORMER
T2	AUXILIARY TRANSFORMER
R1	RECTIFIER
F1,F2	FEEDER CUBICLES
ND	NEGATIVE DRAINAGE COMPARTMENT
CP	CONTROL PANEL
L	OUTDOOR LIGHT FIXTURE
SKP	INTRUSION ALARM KEY PAD


CONDUIT NUMBER	CONDUIT SIZE	FUNCTION
1	4"	12KV AC UTILITY INCOMING CABLE
2	4"	12KV AC UTILITY INCOMING CABLE (SPARE)
3-6	4"	DC POSITIVE FEEDER CABLES
7-10	2"	DC NEGATIVE DRAINAGE CABLES
11-16	4"	DC NEGATIVE RETURN CABLES
17-18	2"	TELEPHONE
19-22	4"	DC FEEDERS FOR FUTURE BREAKERS

NOTES:

- THIS DRAWING SHOWS A GENERAL LAYOUT OF MAJOR EQUIPMENT. REFER TO THE TECHNICAL SPECIFICATIONS FOR DETAILED REQUIREMENTS.
- CONTRACTOR MAY PROVIDE AN ALTERNATIVE LAYOUT PLAN SUBJECT TO THE ENGINEER'S APPROVAL. THE LENGTH OF THE SUBSTATION MAY BE REDUCED SUBJECT TO THE ENGINEER'S APPROVAL.
- CONTRACTOR SHALL PROVIDE ACCESS DOORS WITH PROVISION FOR UTILITY CO(S) PADLOCK FOR THE 12KV UTILITY METERING COMPARTMENT IN ACCORDANCE WITH UTILITY CO(S) REQUIREMENTS.
- MOUNT JUNCTION BOX ABOVE DOOR OF METERING CUBICLE.
- PROVIDE BRONZE PAD WITH TAP HOLES CONFORMING TO NEMA SPACING REQUIREMENTS FOR 1/2 INCH 13 SILICON BRONZE BOLTS. EACH PAD SHALL BE 4 SQUARE INCH WITH 4 HOLES AT 1 3/4 INCH CENTERS.
- CUTOUPS FOR INCOMING AND OUTGOING CABLES SHALL BE PROVIDED AS REQUIRED.
- MAXIMUM WIDTH OF EACH HINGED DOOR ON THE SWITCHGEAR SIDE OF SUBSTATION SHALL NOT EXCEED 2'-0".
- PROVIDE INTRUSION ALARM DOOR LIMIT SWITCHES ON ALL EXTERIOR DOORS.
- AT SUBSTATION YRY1, PROVIDE ADDITIONAL DC FEEDER BREAKERS AS INDICATED ON DWG TP507. ADJUST ENCLOSURE SIZE AS NEEDED.
- SPACE FOR ONE FUTURE BREAKER IS REQUIRED FOR THE SUBSTATION YRY1.

PROJECT CONTROL DATE: 10/09/97 08:38:10 CAD FILENAME: C:\UT\35105\10.DWG (C25) RD/DWL PLOTTED SCALE: 1/2"=1'-0"

REV	DATE	DESCRIPTION
1	11/11/02	AS-BUILT MARK UP BY UTA
2	4/15/97	ISSUED FOR CONSTRUCTION

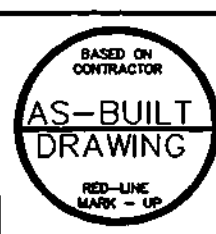

Submitted By: _____

UTA TRAX
SALT LAKE BUS/RAIL PROJECT
UTAH TRANSIT AUTHORITY


Approved By: _____

Designed By:
R.C. DHINGRA
Drawn By:
D.H. LUU
Checked By:
E.J. ROWE
Approved By:
J.H. KATZ

**TRACTION POWER SUBSTATION
PROCUREMENT**
TYPICAL SUBSTATION
EQUIPMENT ARRANGEMENT
SUBSTATIONS AT GRADE LEVEL AND YRY1



Scale:
1/2"=1'-0"
CADD Filename:
L35TP510
Submitted Date:
12/23/98
UTA Contract No.:
UT-111V-L35
Drawing No.:
TP510
Sheet No.:
10

PROJECT CONTROL DATE: 10/09/97 08:45:40 CAO FILENAME: C:\UTA\3510512.DWG (C23) RD/DHL PLOTTED SCALE: 1=32'<0>


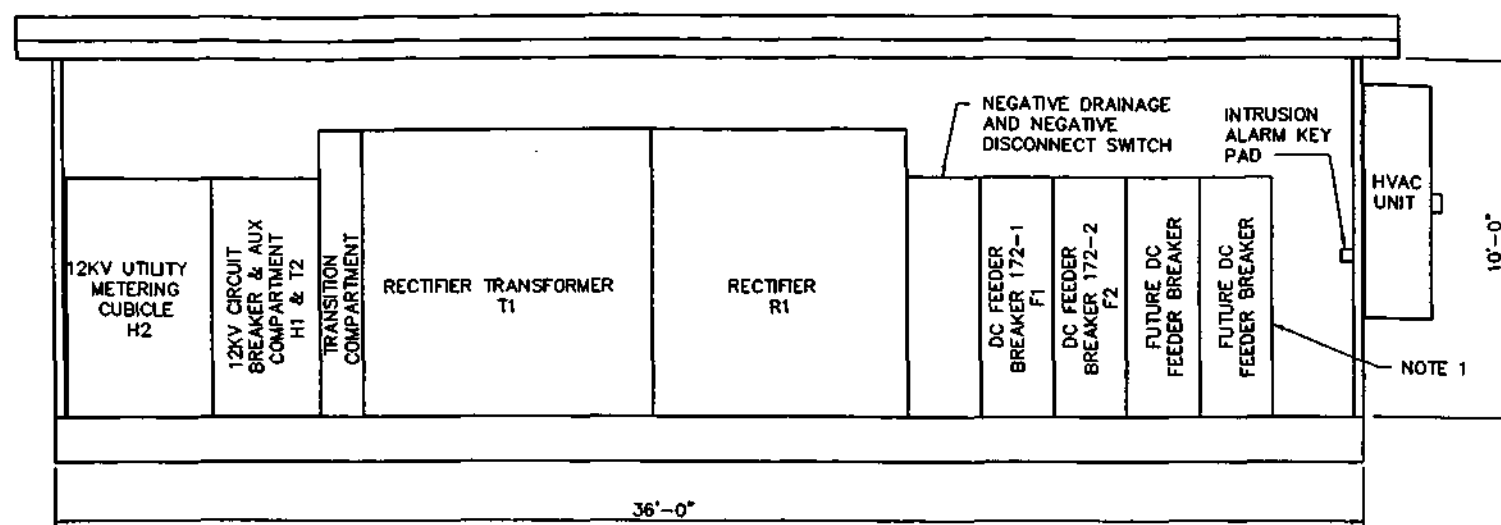


NOTE:

1. FOR SUBSTATION YRY1, PROVIDE ADDITIONAL DC FEEDERS AS INDICATED ON DRAWING TP507 AND SPACE FOR ONE FUTURE DC FEEDER BREAKER. ADJUST ENCLOSURE SIZE AS NEEDED.

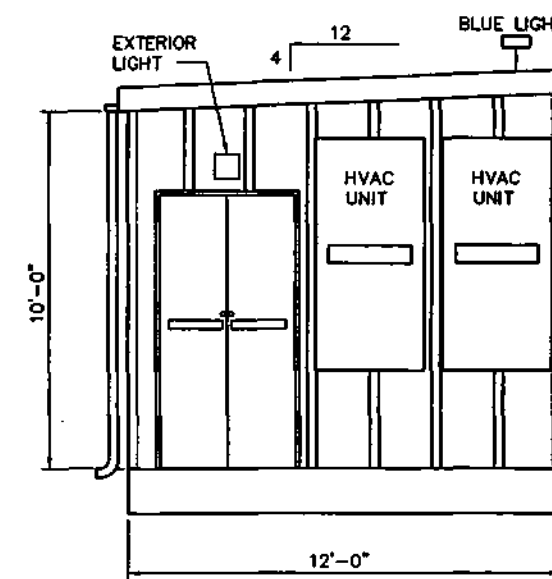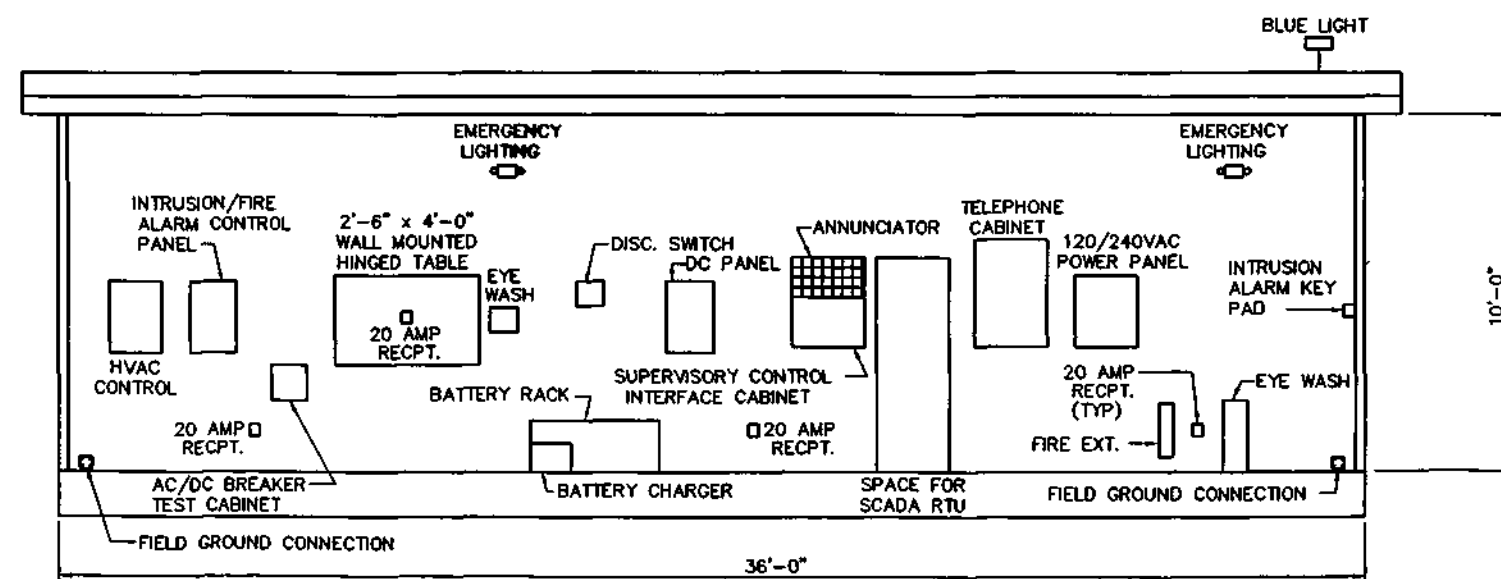


REV	DATE	DESCRIPTION
AS	11/11/02	AS-BUILT MARK UP BY UTA
A	4/15/97	ISSUED FOR CONSTRUCTION

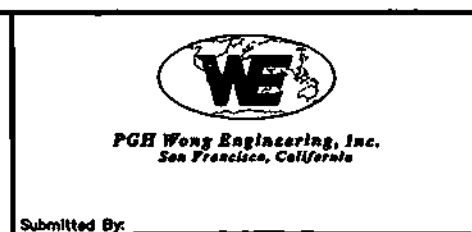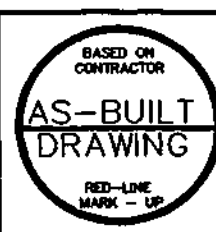


Designed By: R.C. DHINGRA
Drawn By: D.S. TALLITSCH
Checked By: E.J. ROWE
Approved By: J.N. KATZ

TRACTION POWER SUBSTATION PROCUREMENT TYPICAL SUBSTATION SECTIONS	
Scale: 3/8"=1'-0"	CADD Filename: L35TP512
Submitted Date: 12/23/98	UTA Contract No.: UT-11VT-L35
Drawing No.: TP512	Sheet No.: 11

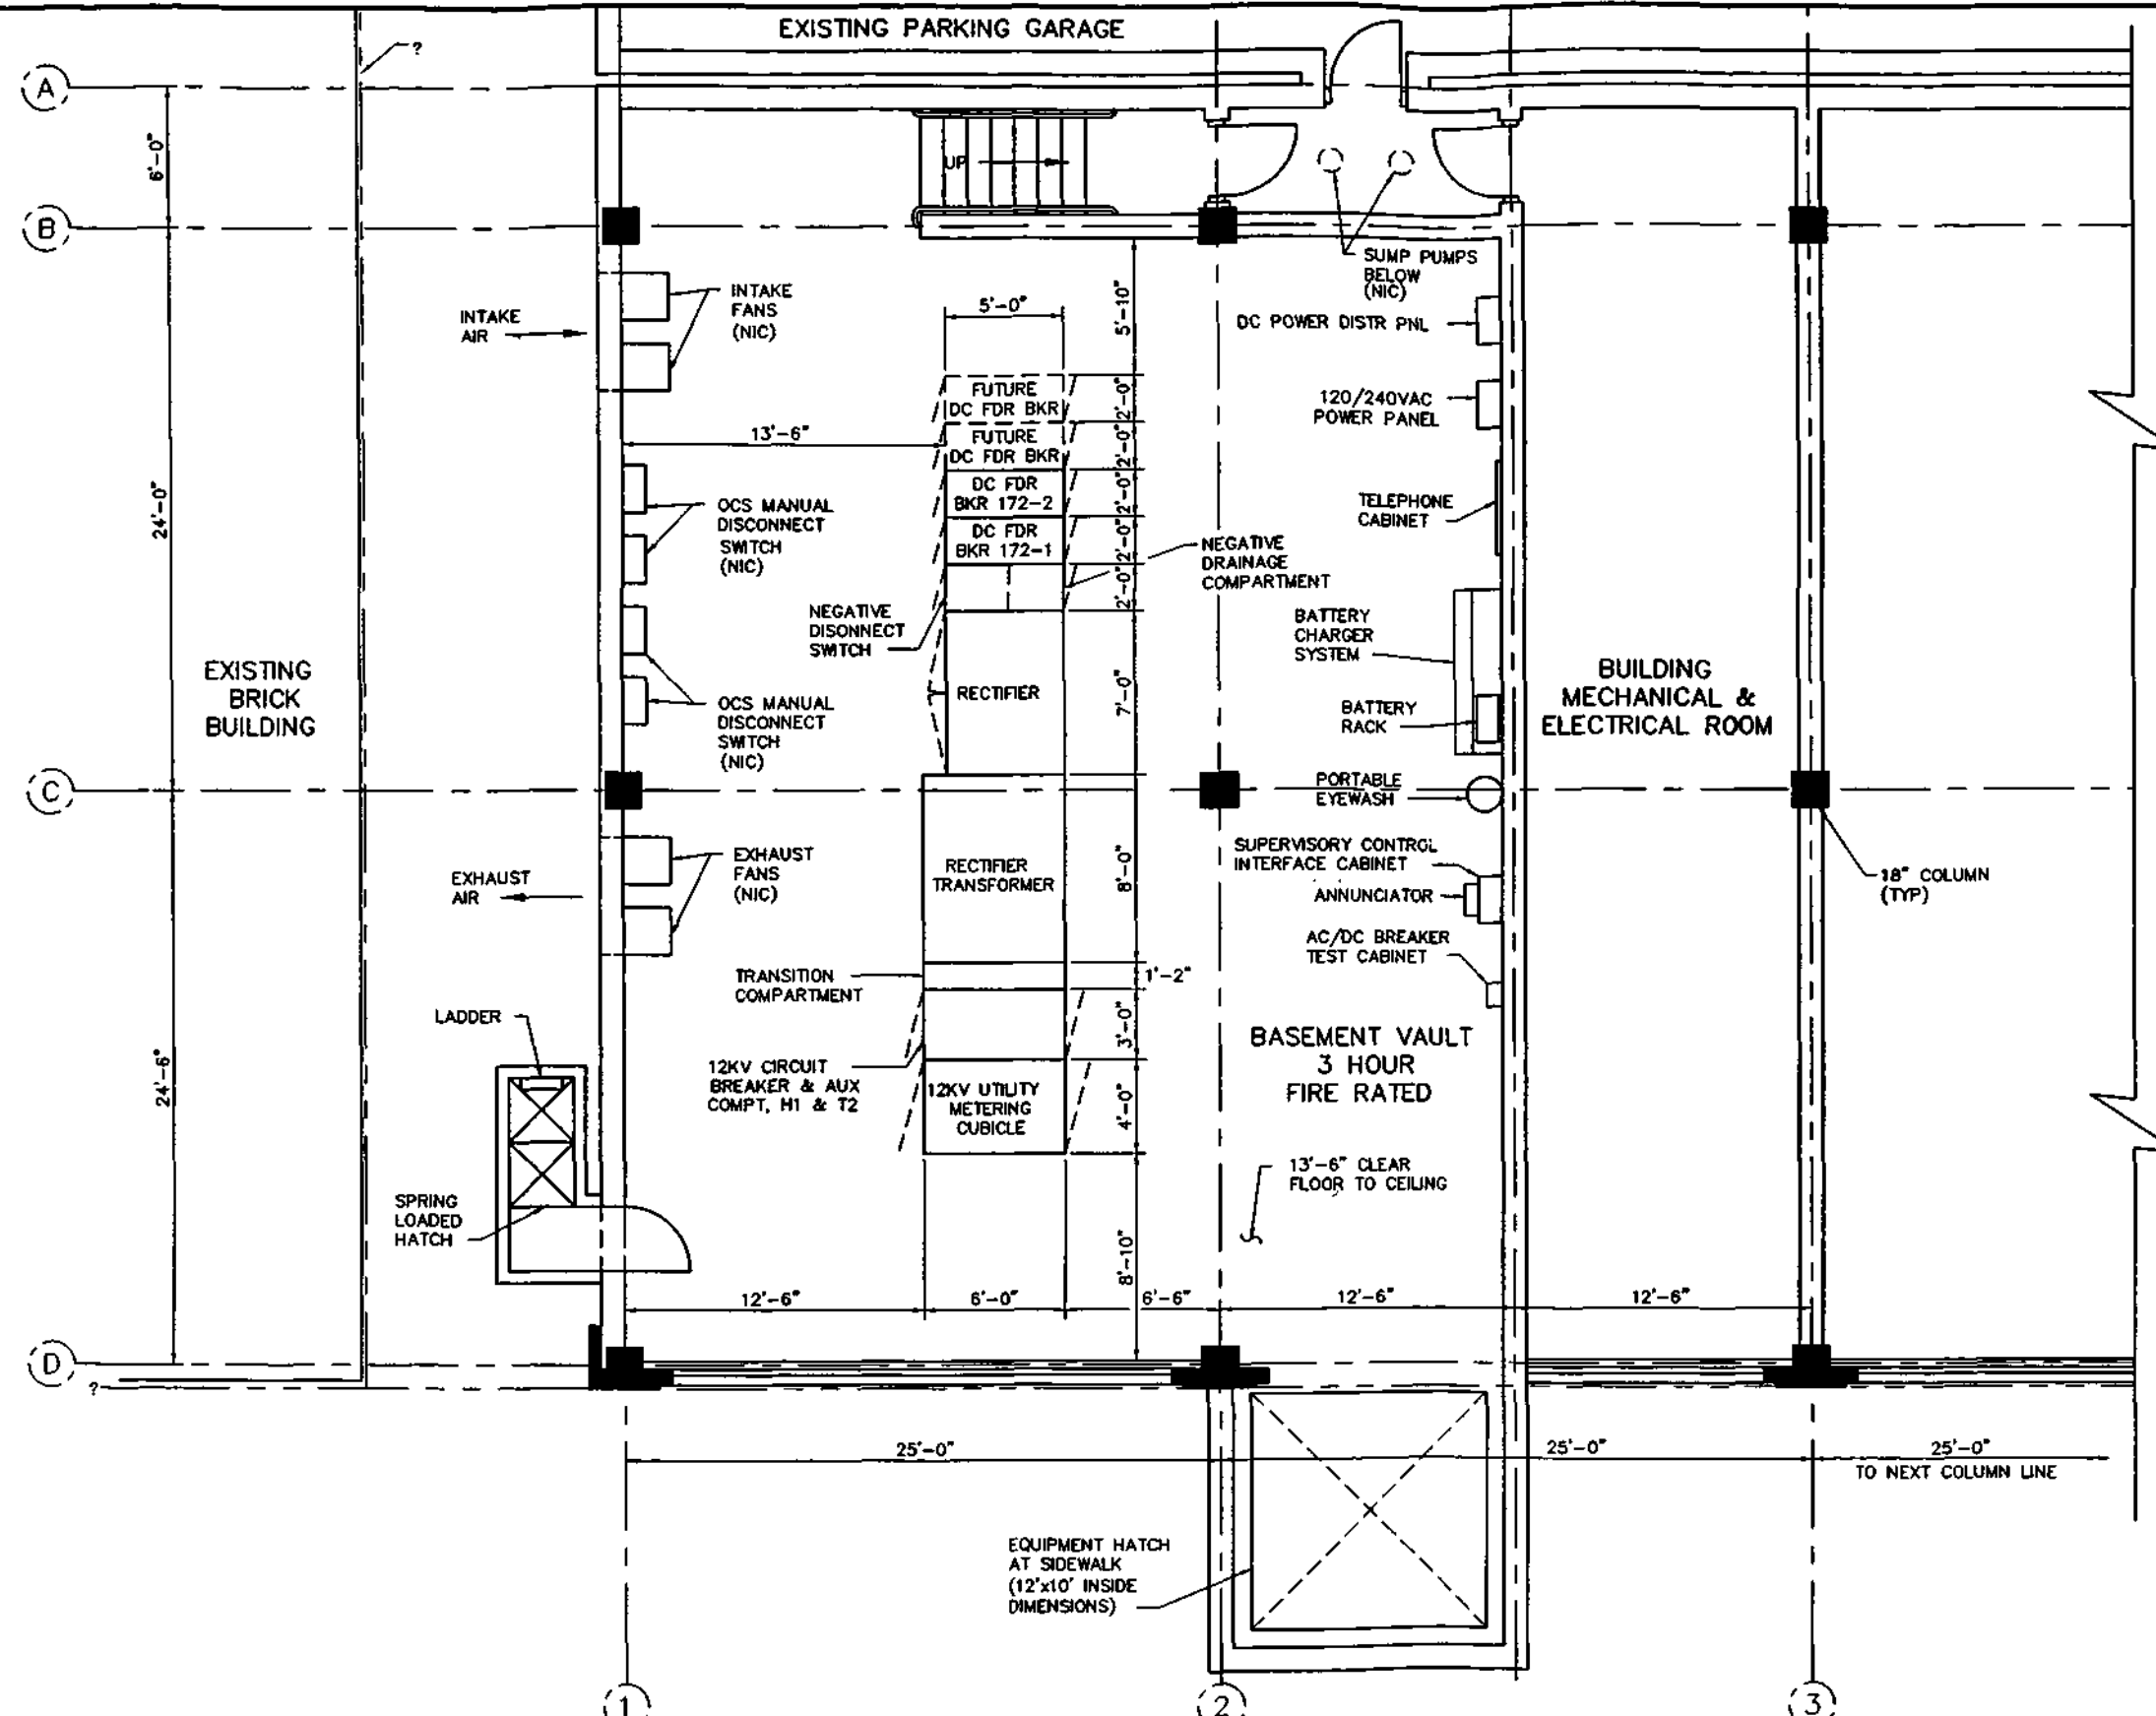

NOTES:
1. EQUIPMENT DIMENSIONS AND CLEARANCES SHOWN FOR INFORMATION ONLY. ENGINEER TO ADVISE CONTRACTOR OF FINAL DIMENSIONS OF STRUCTURE AND LOCATIONS OF EQUIPMENT.

REV	DATE	DESCRIPTION
1	11/11/02	AS-BUILT MARK UP BY UTA
2	1/15/97	ISSUED FOR CONSTRUCTION

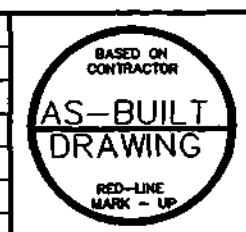

PGH Wong Engineering, Inc.
San Francisco, California

Submitted By: _____

UTA TRAX
SALT LAKE BUS/RAIL PROJECT
UTAH TRANSIT AUTHORITY

Designed By: R.C. DHINGRA
Drawn By: D.S. TALLUTSCH
Checked By: E.J. ROWE
Approved By: J.M. KATZ

Approved By: _____

TRACTION POWER SUBSTATION
PROCUREMENT
SUBSTATION EQUIPMENT ARRANGEMENT
UNDERGROUND VAULT
SUBSTATION SRT2

Scale: 1/4" = 1'-0"
CADD Filename: L35TP514
Submitted Date: 12/23/98
UTA Contract No.: UT-11VT-L35
Drawing No.: TP514
Sheet No.: 12